

STATE OF KANSAS  
STATE CORPORATION COMMISSION

WELL PLUGGING RECORD

Give All Information Completely  
Make Required Affidavit  
Mail or Deliver Report to  
Conservation Division  
State Corporation Comm.  
245 North Water  
Wichita, KS 67202


Ness County. Sec. 36 Twp. 17S Rge. 21WE/W  
Location as "NE/CNW $\frac{1}{4}$ SW $\frac{1}{4}$ " or footage from lines  
SW NE NW

Lease Owner F & M Oil Company

Lease Name CASEY Well No. 1

Office Address 505 Union Center, Wichita, Kansas

Character of Well (Completed as Oil, Gas or Dry Hole)  
Dry Hole

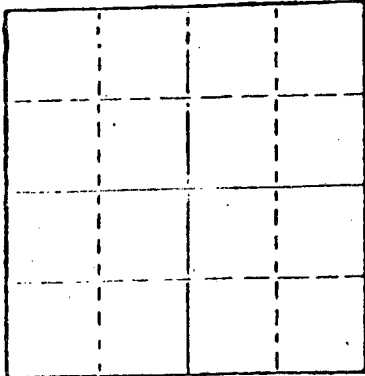

Locate well correctly on above  
Section Plat

Date Well completed Oct. 2 1979

Application for plugging filed (verbally) Oct. 2 1979

Application for plugging approved (verbally) Oct. 2 1979

Plugging commenced Oct. 2 1979

Plugging completed Oct. 2 1979

Reason for abandonment of well or producing formation

No commercial quantity of oil or gas encountered

If a producing well is abandoned, date of last production

19

Was permission obtained from the Conservation Division or  
its agents before plugging was commenced? Yes

Name of Conservation Agent who supervised plugging of this well Leo Massey

Producing formation Depth to top Bottom Total Depth of Well 4185'

Show depth and thickness of all water, oil and gas formations.

OIL, GAS OR WATER RECORDS

CASING RECORD

FORMATION	CONTENT	FROM	TO	SIZE	PUT IN	PULLED OUT

Describe in detail the manner in which the well was plugged, indicating where the mud fluid  
was placed and the method or methods used in introducing it into the hold. If cement or other  
plugs were used, state the character of same and depth placed, from \_\_\_\_\_ feet to  
\_\_\_\_\_ feet for each plug set.

T.D. 4185'

Set 1st plug at 775' with 70 sacks

2nd plug at 380' with 20 sacks

3rd plug at 40' solid bridge with 10 sacks

rathole with 5 sacks

Cemented with 50/50 posmix, 6% gel.

Plug was down at 12:45 a.m., 10-02-79.

(If additional description is necessary, use BACK of this sheet)

Name of Plugging Contractor Abercrombie Drilling, Inc.

STATE OF Kansas COUNTY OF Sedgwick, ss.  
Jack L. Partridge, Asst. Sec.-Treas. (employee of owner) or (owner or operator)  
of the above-described well, being first duly sworn on oath, says: That I have knowledge of  
the facts, statements, and matters herein contained and the log of the above-described well  
as filed and that the same are true and correct. So help me God.



(Signature) Jack L. Partridge  
801 Union Center, Wichita, Kansas

(Address)

SUBSCRIBED AND SWORN TO before me this 11th day of October, 1979.

My commission expires 08-21-82

Sherrie L. Brooks  
Notary Public.

RECEIVED  
STATE CORPORATION COMMISSION

OCT 12 1979

CONSERVATION DIVISION  
Wichita, Kansas

CONTRACTOR'S WELL LOG

OPERATOR: F & M Oil Company  
 CONTRACTOR: Abercrombie Drilling, Inc.  
 WELL NAME: Casey #1  
 LOCATION: SW NE NW, Section 36-17S-21W,  
 Ness County, Kansas  
 SPUD DATE: September 24, 1979  
 COMPLETION DATE: October 02, 1979

0	387	Surface soil, sand and shale
387	1405	Sand and shale
1405	1430	Anhydrite
1430	2132	Sand and shale
2132	2371	Shale and sand
2371	2764	Shale and red bed
2764	3970	Shale and lime
3970	4111	Lime
4111	4145	Sand and shale
4145	4185	Lime
	4185	Rotary Total Depth

Spud hole at 6:15 p.m., September 24, 1979. Drilled 387' of 12 1/4" hole. Ran 13 joints of 8-5/8" - 28# casing. Set at 382.77' with 225 sacks of common cement, 3% Ca.Cl., 2% gel. Cement did circulate. Plug was down at 6:15 a.m., September 25, 1979.

T.D. 4185'. Set 1st plug at 775' with 70 sacks, 2nd plug at 380' with 20 sacks, 3rd plug at 40' solid bridge with 10 sacks, rathole with 5 sacks. Cemented with 50/50 posmix, 6% gel. Plug was down at 12:45 a.m., October 02, 1979.

SAMPLE TOPS:

Anhydrite 1405'  
 B/Anhydrite 1430'

RECEIVED  
 STATE CORPORATION COMMISSION

OCT 12 1979

CONSERVATION DIVISION  
 Wichita, Kansas


STATE OF KANSAS )  
 ) ss  
 COUNTY OF SEDGWICK )

Jack L. Partridge, Assistant Secretary-Treasurer of Abercrombie Drilling, Inc., does hereby state that the above and foregoing is a true, and correct copy of the log of the Casey #1, SW NE NW, Section 36-17S-21W, Ness County, Kansas.

ABERCROMBIE DRILLING, INC.

BY Jack L. Partridge  
 Jack L. Partridge  
 Assistant Secretary-Treasurer

Subscribed and sworn to before me, a Notary Public, in and for the county and state aforesaid, as of this 11th day of October, 1979.

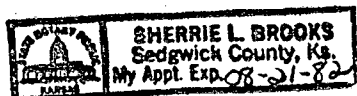

Sherrie L. Brooks  
 Sherrie Brooks, Notary Public

My commission expires 08-21-82.