


15-135-00103-00-00

STATE OF KANSAS
STATE CORPORATION COMMISSION

Give All Information Completely
Make Required Affidavit
Mail or Deliver Report to:
Conservation Division
State Corporation Commission
800 Biting Building
Wichita, Kansas

WELL PLUGGING RECORD

Ness County. Sec. 7 Twp. 17 Rge. 25 (27) (W) XX
Location as "NE/CNW $\frac{1}{4}$ /SW $\frac{1}{4}$ " or footage from lines NE NE NW
Lease Owner Hilton Drilling Company, Inc.
Lease Name Stutz Well No. 1
Office Address Great Bend, Kansas
Character of Well (completed as Oil, Gas or Dry Hole) Dry Hole
Date well completed July 8, 1956
Application for plugging filed July 8, 1956
Application for plugging approved July 8, 1956
Plugging commenced July 9, 1956
Plugging completed July 9, 1956
Reason for abandonment of well or producing formation Dry Hole

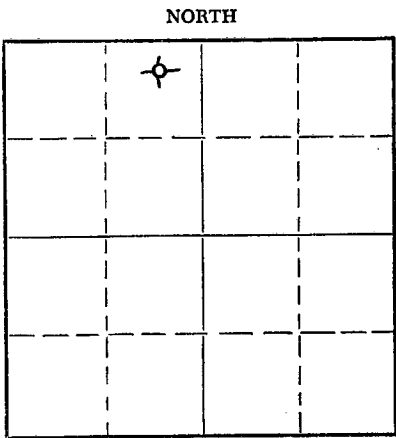

Locate well correctly on above
Section Flat

If a producing well is abandoned, date of last production 19
Was permission obtained from the Conservation Division or its agents before plugging was commenced? Yes

Name of Conservation Agent who supervised plugging of this well R. M. Brundage
Producing formation Depth to top Bottom Total Depth of Well 4865 Feet
Show depth and thickness of all water, oil and gas formations.

OIL, GAS OR WATER RECORDS

CASING RECORD

FORMATION	CONTENT	FROM	TO	SIZE	PUT IN	PULLED OUT
		0	241	8-5/8"	241	None

Describe in detail the manner in which the well was plugged, indicating where the mud fluid was placed and the method or methods used in introducing it into the hole. If cement or other plugs were used, state the character of same and depth placed, from feet to feet for each plug set.

Put in heavy drilling mud from total depth to 240'
Plugged hole with bottom plug and 1/3 sacks hulls @ 240' and
20 sacks cement.
Top plug at 35' with 1/3 sacks hulls and 10 sacks cement.

(If additional description is necessary, use BACK of this sheet)
Name of Plugging Contractor Hilton Drilling Company, Inc.
Address Great Bend, Kansas

STATE OF KANSAS, COUNTY OF BARTON, ss.
Henry Peacock, Secretary (employee of owner) or (owner or operator) of the above-described well, being first duly sworn on oath, says: That I have knowledge of the facts, statements, and matters herein contained and the log of the above-described well as filed and that the same are true and correct. So help me God.

(Signature) Henry Peacock
Great Bend, Kansas
(Address)

SUBSCRIBED AND SWORN TO before me this 11th day of July, 1956
Mildred Hobbe
Notary Public.



PLUGGING
FILE SEC 7 T 17 R 25W
BOOK PAGE 78 LINE 39

24-7368-S 3-53-20M
MILDRED HOBBE
MY COMMISSION EXPIRES MARCH 6, 1958
7-13-56
WICHITA DIVISION

DRILLER'S LOG

COMPANY: Hilton Drilling Company, Inc. LOCATION: NE NE NW
 Sec. 7-17S-25W
 CONTRACTOR: Hilton Drilling Company, Inc. Ness County, Kansas
 FARM NAME: Stutz No. 1 ELEVATION: 2532 D.F.
 COMMENCED: June 22, 1956 Casing Used: 8-5/8" set @ 241' w/175 sxs.
 COMPLETED: July 9, 1956

Clay	28
Sand	33
Shale	555
Shale and Shells	795
Sand	840
Red Bed	1275
Lime	1292
Red Bed, Shale and Sand	1690
Shale and Shells	1825
Red Bed, Shale and Shells	1878
Anhydrite	1910
Shale and Shells	2030
Shale and Lime	2715
Lime	2945
Shale and Lime	3871
Lime	4084
Shale and Lime	4122
Lime	4207
Shale and Lime	4259
Lime	4383
Shale and Lime	4460
Conglomerate	4477
Lime	4548
Chert and Lime	4610
Lime	4657
Cherty Lime	4708
Chert and Lime	4774
Shale and Lime	4812
Lime	4851
Chert and Lime	4865
Total Depth	4865

STATE OF KANSAS)
 COUNTY OF BARTON) SS.

I, the undersigned, being duly sworn on oath, state that the above statement and log are true and a correct record and log of the well drilled at the location above-described.

RECEIVED
 STATE CORPORATION COMMISSION

JUL 17 1956

HILTON DRILLING COMPANY, INC.

CONSERVATION DIVISION

Subscribed and sworn to before me this 11th day of July, 1956

[Signature]

PLUGGING
 FILE SEC 7 T 17 R 25W
 BOOK PAGE 78 LINE 39

Mildred Hobbie
 Notary Public

MILDRED HOBBIIE
 MY COMMISSION EXPIRES MARCH 6, 1958

MAILED
 JUL 17 1956
 STATE CORPORATION COMMISSION