

STATE OF KANSAS
STATE CORPORATION COMMISSION

WELL PLUGGING RECORD

Give All Information Completely
Make Required Affidavit
Mail or Deliver Report to:
Conservation Division
State Corporation Commission
212 No. Market
Wichita, Kansas

Ness County, Sec. 28 Twp. 17S Rge. 21W (E) (W)

Location as "NE/CNW/SW" or footage from lines C SE NE

Lease Owner Halliburton Oil Producing Co.

Lease Name Wagner Well No. 1

Office Address 520 Cameron Bldg., Oklahoma City, Okla., 73106

Character of Well (completed as Oil, Gas or Dry Hole) Dry Hole

Date well completed May 29 19 69

Application for plugging filed May 29 19 69

Application for plugging approved May 29 19 69


Plugging commenced May 29 19 69

Plugging completed May 29 19 69

Reason for abandonment of well or producing formation Dry Hole

If a producing well is abandoned, date of last production 19

Was permission obtained from the Conservation Division or its agents before plugging was commenced? Yes

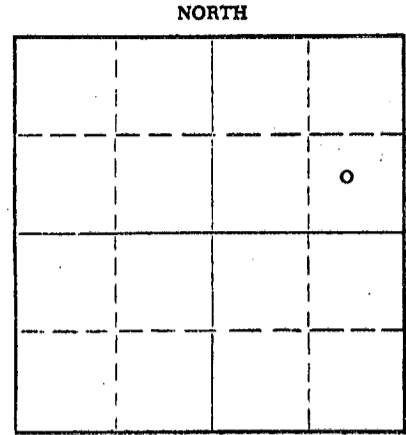

Locate well correctly on above Section Flat

Name of Conservation Agent who supervised plugging of this well Eldon Petty, Hays, Kansas

Producing formation Depth to top Bottom Total Depth of Well 4295' Feet

Show depth and thickness of all water, oil and gas formations.

OIL, GAS OR WATER RECORDS

CASING RECORD

FORMATION	CONTENT	FROM	TO	SIZE	PUT IN	PULLED OUT
		0	413'	8 5/8"	413'	None

Describe in detail the manner in which the well was plugged, indicating where the mud fluid was placed and the method or methods used in introducing it into the hole. If cement or other plugs were used, state the character of same and depth placed, from feet to feet for each plug set.

Plug: 600'/50 sacks cement
390'/25 sacks cement
40'/10 sacks cement on solid bridge

RECEIVED
STATE CORPORATION COMMISSION

JUN 5 1969

CONSERVATION DIVISION
Wichita, Kansas

06-05-1969

(If additional description is necessary, use BACK of this sheet)

Name of Plugging Contractor Hellar Drilling Company, Inc.
Address 339 Union Center Bldg., Wichita, Kansas 67202

STATE OF Kansas, COUNTY OF Sedgwick, ss.

D. L. Hellar, Pres. of Hellar Drilling Company, Inc. (employee of owner) or (owner or operator) of the above-described well, being first duly sworn on oath, says: That I have knowledge of the facts, statements, and matters herein contained and the log of the above-described well as filed and that the same are true and correct. So help me God.

(Signature) D. L. Hellar, President
339 Union Center Bldg., Wichita, Kansas 67202
(Address)



Subscribed and sworn to before me this 4th day of June, 19 69

My commission expires March 25, 1972

Catherine Darcey - Notary Public.

15-135-20254-00-00

DRILLER'S LOG

COMPANY: Halliburton Oil Producing Co., Oklahoma City, Okla.
 CONTRACTOR: Hellar Drilling Company, Inc., Wichita, Kansas
 LEASE: #1 Wagner
 LOCATION: C SE NE 28-17S-21W, Ness County, Kansas
 COMMENCED: May 18, 1969
 COMPLETED: May 29, 1969
 CASING: Set 8 5/8" Surface Casing @ 413'/265 sacks cement

0-413	Sand & Shale (Post Rock)
413-520	Shale & Sand
520-835	Shale
835-1345	Shale & Sand Red Beds
1345-1446	Shale & Red Bed
1446-1482	Anhydrite
1482-2195	Shale & Red Bed
2195-3863	Lime & Shale
3863-3930	Lime
3930-4215	Lime & Shale
4215-4220	Lime
4220-4295	Miss.
4295	Rotary Total Depth

RECEIVED
 STATE CORPORATION COMMISSION
 JUN 5 1969
 CONSERVATION DIVISION
 Wichita, Kansas

06-05-1969

D & A

STATE OF KANSAS)
) SS
 COUNTY OF SEDGWICK)

I, D. L. Hellar, do hereby certify that the above and foregoing is a true and correct copy of the log of the #1 Wagner, located in C SE NE 28-17S-21W, Ness County, Kansas, as reflected by the files of the Hellar Drilling Company, Inc.

HELLAR DRILLING COMPANY, INC.

By *D. L. Hellar*
 President - D. L. Hellar

Subscribed and sworn to before me, a Notary Public, in and for Sedgwick County, Kansas, this 4th day of June, 1969.

Catherine Darcey
 Notary Public - Catherine Darcey

My Commission Expires: March 25, 1972.

