

STATE OF KANSAS CORPORATION COMMISSION


WELL PLUGGING RECORD

FORMATION PLUGGING RECORD

Strike out upper line when reporting plugging off formations.

Give All Information Completely Make Required Affidavit Mail or Deliver Report to: Conservation Division State Corporation Commission 800 Bittling Building Wichita, Kansas

Ellis County. Sec. 5 Twp. 11 Rge. (E) 18 (W) Location as "NE 1/4 NW 1/4 SW 1/4" or footage from lines. C. of SE, SE, NW Lease Owner Jones, Shelburne & Farmer, Inc Lease Name Richard Well No. 1 Office Address Russell, Kansas Character of Well (completed as Oil, Gas or Dry Hole) Dry hole Date well completed 3-19th 19 48 Application for plugging filed 3-19th 19 48 Application for plugging approved 3-19th 19 48 Plugging commenced 3-20th 19 48 Plugging completed 3-20th 19 48 Reason for abandonment of well or producing formation Dry

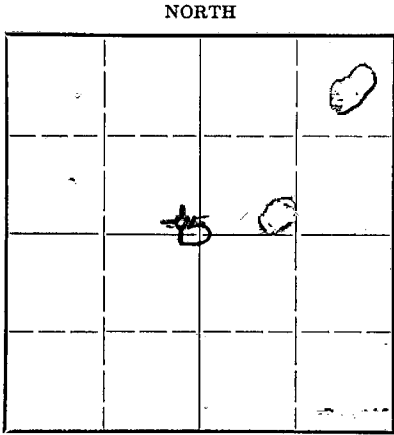

Locate well correctly on above Section Plat

If a producing well is abandoned, date of last production never produced Was permission obtained from the Conservation Division or its agents before plugging was commenced? yes

Name of Conservation Agent who supervised plugging of this well Mr M.A. Rives Producing formation none Depth to top Bottom Total Depth of Well 3403 Feet Show depth and thickness of all water, oil and gas formations.


OIL, GAS OR WATER RECORDS

CASING RECORD

Table with 7 columns: Formation, Content, From, To, Size, Put In, Pulled Out. Row 1: None encountered, 8 5/8", 200', none

Describe in detail the manner in which the well was plugged, indicating where the mud fluid was placed and the method or methods used in introducing it into the hold. If cement or other plugs were used, state the character of same and depth placed, from feet to feet for each plug set.

Hole was filled to top with heavy mud and 20 sacks of cement mixed and spotted in bottom of surface pipe. Hole filled to within 30' of top with mud and 15 sacks of cement mixed and dumped in top of surface pipe.

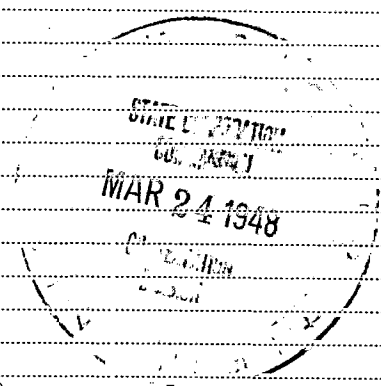

(If additional description is necessary, use BACK of this sheet)

Correspondence regarding this well should be addressed to Jones, Shelburne & Farmer, Inc Address Russell, Kansas

STATE OF Kansas, COUNTY OF Russell, ss.

(employee of owner) or (owner or operator) of the above-described well, being first duly sworn on oath, says: That I have knowledge of the facts, statements, and matters herein contained and the log of the above-described well as filed and that the same are true and correct. So help me God.

(Signature) John O Farmer Russell Kans (Address)

22nd day of March 19 48

Floyd W. Harnaker Notary Public.

My commission expires January 5-1952

PLUGGING FILE SEC 5 T 11 R 18a BOOK PAGE 18 LINE 30

CONTRACTOR'S VERIFIED LOG

Operator Jones-Shelburne & Farmer Inc Farm Name Richards Well No. 1

Location Cof SE, SE, NW 6-11-18W

Pool Name Richards County Ellis Kansas

Commencement Date February 22-1948 Completion Date March 19-1948

LOG OF WELL

Depth		Formation	Deviation from Vertical (Degrees)	Remarks
From	To			
0	85	surface rock & shale		
85	183	shale (part surface)		
183	395	shale		
395	610	shale & shells		
610	715	shale & sand		
715	865	shale & shells		
865	1080	sand & shale		
1080	1410	Red rock & shale		
1410	1446	anhydrite		
1446	1760	Shale & shells		
1760	1805	Salt		
1805	1980	Shale & shells		
1980	2340	Shale & lime		
2340	2360	Iron & Lime		
2360	2605	Lime & Shale		
2605	2962	Shale & lime		
2962	3080	Lime & Shale		
3080	3110	Shale & lime		
3110	3256	Lime & shale		
3256	3404	Lime		



PLUGGING
 FILE SEC 5 T 11 R 18W
 BOOK PAGE 18 LINE 30

