


Give All Information Completely
Make Required Affidavit
Mail or Deliver Report to:
Conservation Division
State Corporation Commission
211 No. Broadway
Wichita, Kansas

WELL PLUGGING RECORD

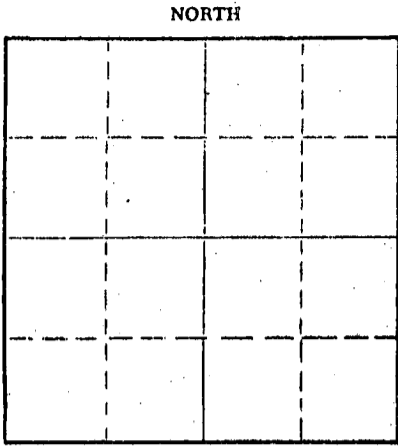

Locate well correctly on above
Section Plat

Location as "NE/CNW&SW" or footage from lines _____
County. Sec. 3 Twp. 17S Rge. 25W (E) _____ (W) _____
NE NE
Lease Owner Thunderbird Drilling, Inc.
Lease Name Mollenkamp "G" Well No. 1
Office Address P. O. Box 18407, Wichita, Kansas 67218
Character of Well (completed as Oil, Gas or Dry Hole) Dry Hole
Date well completed 8-16 19 76
Application for plugging filed 8-16 19 76
Application for plugging approved 8-16 19 76
Plugging commenced 8-16 19 76
Plugging completed 8-16 19 76
Reason for abandonment of well or producing formation _____

If a producing well is abandoned, date of last production _____ 19 _____
Was permission obtained from the Conservation Division or its agents before plugging was commenced? Yes

Name of Conservation Agent who supervised plugging of this well Leo Massey
Producing formation _____ Depth to top _____ Bottom _____ Total Depth of Well _____ Feet
Show depth and thickness of all water, oil and gas formations.

OIL, GAS OR WATER RECORDS

CASING RECORD

| FORMATION | CONTENT | FROM | TO | SIZE | PUR IN | PULLED OUT |
|-----------|---------|------|-----|--------|--------|------------|
| Surface | | 0 | 337 | 8 5/8" | 337 | 0 |
| | | | | | | |
| | | | | | | |
Describe in detail the manner in which the well was plugged, indicating where the mud fluid was placed and the method or methods used in introducing it into the hole. If cement or other plugs were used, state the character of same and depth placed, from _____ feet to _____ feet for each plug set.

1st Plug @ 720' w/70 sx
2nd Plug @ 240' w/20 sx
3rd Plug @ 40' w/8 sx

RECEIVED
STATE CORPORATION COMMISSION
AUG 27 1976
CONSERVATION DIVISION
Wichita, Kansas

(If additional description is necessary, use BACK of this sheet)
Name of Plugging Contractor Thunderbird Drilling, Inc.
Address P. O. Box 18407, Wichita, Kansas 67218

STATE OF Kansas COUNTY OF Sedgwick, ss.
Burke Krueger

(employee of owner) or (owner or operator) of the above-described well, being first duly sworn on oath, says: That I have knowledge of the facts, statements, and matters herein contained and the log of the above-described well as filed and that the same are true and correct. So help me God.

(Signature) Burke Krueger

P. O. Box 18407, Wichita, Kansas 67218

SUBSCRIBED AND SWORN TO before me this 25th day of August, 19 76

Gloria DeJesus
Gloria DeJesus

Notary Public.

My commission expires 3-25-80

