

JAN - 3 1979

STATE OF KANSAS STATE CORPORATION COMMISSION


WELL PLUGGING RECORD

CONSERVATION DIVISION Wichita, Kansas

Give All Information Completely Make Required Affidavit Mail or Deliver Report to Conservation Division State Corporation Comm. 245 North Water Wichita, KS 67202

Ness County, Sec. 3 Twp. 17S Rge. 25 SW Location as "NE/CNW/SW" or footage from lines

C-SW-NW Lease Owner Liberty Enterprises, Inc. Lease Name Mollemkamp Well No. "B" #1 Office Address 308 West Mill Plainville, Kansas 67663 Character of Well (Completed as Oil, Gas or Dry Hole) Dry Hole

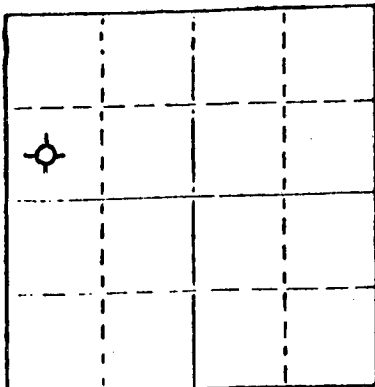

Locate well correctly on above Section Plat

Date Well completed December 28 1978 Application for plugging filed December 28 1978 Application for plugging approved December 28 1978 Plugging commenced December 28 9:00 A.M. 1978 Plugging completed December 28 11:30 A.M. 1978 Reason for abandonment of well or producing formation

no commercial production If a producing well is abandoned, date of last production 19

Was permission obtained from the Conservation Division or its agents before plugging was commenced? yes

Name of Conservation Agent who supervised plugging of this well Leo F. Massey Producing formation Depth to top Bottom Total Depth of Well Show depth and thickness of all water, oil and gas formations.

OIL, GAS OR WATER RECORDS

CASING RECORD

Table with 7 columns: FORMATION, CONTENT, FROM, TO, SIZE, PUT IN, PULLED OUT. Row 1: surface casing, common, 0, 321.62, 8 5/8", 321.62', 0.

Describe in detail the manner in which the well was plugged, indicating where the mud fluid was placed and the method or methods used in introducing it into the hold. If cement or other plugs were used, state the character of same and depth placed, from feet to feet for each plug set.

plug #1 @ 720' with 70 sxs plug #2 @ 300' with 20 sxs plug #3 @ 40' with 10 sxs 1 sxs hulls solid bridge 50-50 poz 6% gel


(If additional description is necessary, use BACK of this sheet)

Name of Plugging Contractor Pioneer Drilling Company, Inc. 308 West Mill Plainville, Kansas 67663

STATE OF Kansas COUNTY OF Rooks, ss. Charles G. Comeau (employee of owner) or (owner or operator) of the above-described well, being first duly sworn on oath, says: That I have knowledge of the facts, statements, and matters herein contained and the log of the above-described well as filed and that the same are true and correct. So help me God

(Signature) Charles G. Comeau 308 West Mill Plainville, Kansas 67663 (Address)

SUBSCRIBED AND SWORN TO before me this 2nd day of January, 1979

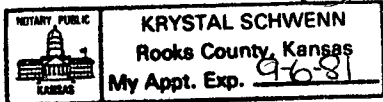

Krystal Schwenn Notary Public.

My commission expires

15-135-21560-00-00

WELL LOG

OPERATOR: Liberty Enterprises, Inc.

WELL NAME: Mollenkamp "B" #1 LOCATION: C. SW. NW. 3-17S-25W

COUNTY: Ness STATE: Kansas

WELL COMMENCED: December 16, 1978 WELL COMPLETED: December 28, 1978

ELEVATION: 2533' KB TOTAL DEPTH: 4550'

PRODUCTION: Dry Hole RIG NO: #1

CASING - 8-5/8": 321' 62' of 28# cemented with 160 sxs common 2% gel 3% cc  
5-1/2": none

ALL MEASUREMENTS TAKEN FROM THE TOP OF ROTARY BUSHING:

FROM	TO	FORMATION	DEVIATION FROM VERTICAL	REMARKS:
0'	20'			
20'	329'	shale and sand		
329'	1005'	shales and sands		
1005'	1750'	sand and shale		
1750'	1884'	shale and shales	1875' - 1 1/4 degrees	
1885'	1906'	Anhydrite		
1907'	1925'	shaled sand		
1925'	2380'	shale and lime		
2380'	2585'	sand and shale		
2585'	2700'	lime and shale		
2700'	2886'	shales and lime		
2886'	3056'	lime and shale		
3056'	3211'	lime and shale		
3211'	3387'	lime and shale		
3387'	3535'	lime and shale		
3535'	3675'	lime and shale		
3675'	3879'	lime and shale		
3879'	4025'	lime and shale		
4025'	4113'	lime		
4113'	4185'	lime		
4185'	4275'	lime		
4275'	4325'	lime	4300' - 3/4 degree	
4325'	4345'	lime		
4345'	4401'	lime		
4401'	4440'	lime		
4440'	4481'	lime		
4481'	4510'	lime		
4510'	4550'	RTD lime		

RECEIVED  
STATE CORPORATION COMMISSION

JAN - 3 1979

CONSERVATION DIVISION  
Wichita, Kansas

STATE OF KANSAS  
COUNTY OF

The undersigned hereby certifies that to the best of his knowledge and belief, the above facts are true and correct

PIONEER DRILLING CO., INC.

By [Signature]

SUBSCRIBED AND SWORN TO, BEFORE ME, This 2nd day of Jan., 1979.

MY COMM. EXP. SEPT. 6, 1981.

Krystal Schwenn  
KRYSTAL SCHWENN - NOTARY PUBLIC

