

CARD MUST BE TYPED

State of Kansas
NOTICE OF INTENTION TO DRILL
(see rules on reverse side)

CARD MUST BE SIGNED

Starting Date: 5 13 85
month day year 3:40

API Number 15- 135-22,819-0000

OPERATOR: License # 4036
Name Pittman & Assoc. Inc.
Address 5921 S. Middlefield Rd.
City/State/Zip Littleton, Co 80123
Contact Person Karalee Belt
Phone (303) 795-6914

..... C. NE SW Sec. 18. Twp. 17 S, Rge. 25 East
(location) West

..... 2130... Ft North from Southeast Corner of Section
..... 3150... Ft West from Southeast Corner of Section
(Note: Locate well on Section Plat on reverse side)

CONTRACTOR: License # 9087
Name R & C Drilling
City/State Hays KS 67601

Nearest lease or unit boundary line 330 feet.
County Ness
Lease Name Norton Well# 2-18

Domestic well within 330 feet: yes no
Municipal well within one mile: yes no

Well Drilled For: Well Class: Type Equipment:
 Oil Swd Infield Mud Rotary
 Gas Inj Pool Ext. Air Rotary
 OWWO Expl Wildcat Cable

Depth to Bottom of fresh water 100 feet
Lowest usable water formation Dakota
Depth to Bottom of usable water 900 feet

If OWWO: old well info as follows:
Operator
Well Name
Comp Date Old Total Depth
Projected Total Depth 4450 feet
Projected Formation at TD Mississippi
Expected Producing Formations

Surface pipe by Alternate: 1 2
Surface pipe to be set 250 feet
Conductor pipe if any required feet
Ground surface elevation feet MSL.
This Authorization Expires 11-9-85
Approved By 5-9-85 RC

I certify that we will comply with K.S.A. 55-101, et seq., plus eventually plugging hole to K.C.C. specifications. Production string will be immediately cemented.

Date 5/9/85 Signature of Operator or Agent Karalee Belt Title As Agent


Must be filed with the K.C.C. five (5) days prior to commencing well
 This card void if drilling not started within six (6) months of date received by K.C.C.

WICHITA, KANSAS
 CONSERVATION DIVISION

MAY 9 1985
 A Regular Section of Land

1 Mile = 5,280 Ft.
 STATE CORPORATION COMMISSION

RECEIVED

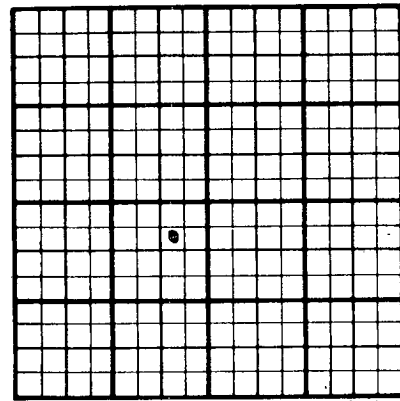

5280
4950
4620
4290
3960
3630
3300
2970
2640
2310
1980
1650
1320
990
660
330

5280
4950
4620
4290
3960
3630
3300
2970
2640
2310
1980
1650
1320
990
660
330

RECEIVED
 CORPORATION COMMISSION

MAY 9 1985

CONSERVATION DIVISION
 Wichita, Kansas

Important procedures to follow :

1. Notify District office before setting surface casing.
2. Set surface casing by circulating cement to the top.
3. File completion forms ACO-1 with K.C.C. within 90 days of well completion, following instructions on ACO-1, side 1, and including copies of wireline logs.
4. Notify District office 48 hours prior to old well workover or re-entry.
5. Prior to plugging, prepare a plugging plan, then obtain agreement from the appropriate district office for an approved plugging plan.
6. Submit plugging report (CP-4) to K.C.C. after plugging is completed.
7. Obtain an approved injection docket number before disposing of salt water.
8. Notify K.C.C. within 10 days when injection commences or terminates.
9. If an alternate 2 completion, cement in the production pipe from below any usable water to surface within 120 days of spud date.

State Corporation Commission of Kansas
 Conservation Division
 200 Colorado Derby Building
 Wichita, Kansas 67202
 (316) 263-3238