

CARD MUST BE TYPED

State of Kansas

CARD MUST BE SIGNED

NOTICE OF INTENTION TO DRILL

(see rules on reverse side)

VJA

Starting Date June 27 1988
month day year

API Number 15-135-23259-00-00

OPERATOR: License # 5815
Name C. & R. Drilling Co.
Address 410 17th St., Suite 1140
City/State/Zip Denver, CO 80202
Contact Person Les Olson
Phone 303/623-6144

W2 W2 NE4 Sec. 6 Twp. 17 S, Rg. 25
3960 Ft. from South Line of Section
2310 Ft. from East Line of Section

(Note: Locate well on Section Plat on reverse side)

CONTRACTOR: License # 9087
Name R. & C. Drilling
City/State Hays, Kansas

Nearest lease or unit boundary line 330 feet
County Ness
Lease Name Hopkins Well # 1

Well Drilled For: Well Class: Type Equipment:
 Oil SWD Infield Mud Rotary
 Gas Inj. Pool Ext. Air Rotary
 OWWO Expl Wildcat Cable

Ground surface elevation 2551 feet MSL
Domestic well within 330 feet: yes no
Municipal well within one mile: yes no
Depth to bottom of fresh water 100
Depth to bottom of usable water 750 / 1000
Surface pipe by Alternate: 1 2
Surface pipe planned to be set 300
Conductor pipe required
Projected Total Depth 4550 feet
Formation Mississippian

If OWWO: old well info as follows:

Operator
Well Name
Comp Date Old Total Depth

I certify that well will comply with K.S.A. 55-101, et seq., plus eventually plugging hole to KCC specifications.

Date 6-21-88 Signature of Operator or Agent *Les Olson* Title Prod. Manager

For KCC Use:

Conductor Pipe Required feet; Minimum Surface Pipe Required 200 feet per Alt. 2

This Authorization Expires 12-23-88 Approved By *Let* 6-23-88

EFFECTIVE DATE: 6-28-88


Must be filed with the K.C.C. five (5) days prior to commencing well
This card void if drilling not started within six (6) months of date received by K.C.C.

Important procedures to follow:

1. Notify District office before setting surface casing.
2. Set surface casing by circulating cement to the top.
3. File completion forms ACO-1 with K.C.C. within 90 days of well completion, following instructions on ACO-1, side 1, and including copies of wireline logs.
4. Notify District office 48 hours prior to old well workover or re-entry.
5. Prior to filing Intent, prepare a proposed plugging plan in case well is D & A, then obtain approval of plan when calling district office prior to setting surface pipe.
6. Submit plugging report (CP-4) to K.C.C. after plugging is completed.
7. Obtain an approved injection docket number before disposing of salt water.
8. Notify K.C.C. within 10 days when injection commences or terminates.

A Regular, Section of Land
1 Mile = 5,280 Ft.

#

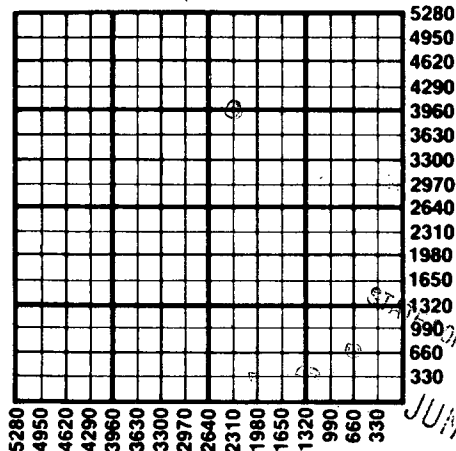

RECEIVED
STATE CORPORATION COMMISSION
JUN 2-3 1988
CONSERVATION DIVISION
Wichita, Kansas

If an alternate 2 completion, cement in the production pipe from below any usable water to surface within 120 days of spud date.

State Corporation Commission of Kansas
Conservation Division
200 Colorado Derby Building
Wichita, Kansas 67202
(316) 263-3238