

CARD MUST BE TYPED

State of Kansas
NOTICE OF INTENTION TO DRILL
(see rules on reverse side)

CARD MUST BE SIGNED

Starting Date: 6 28 1985
month day year

API Number 15- 135-22852-00-00

OPERATOR: License # 5804

NE SE NW Sec 4 Twp 17 S, Rge 25 East
(location) West

Name Drilling Ltd. of Colorado

Address 410 - 17th st., Suite 1140

City/State/Zip Denver, Colorado 80202

Contact Person Les Olson

Phone (303) 623-6144

3415 Ft North from Southeast Corner of Section

3090 Ft West from Southeast Corner of Section

(Note: Locate well on Section Plat on reverse side)

CONTRACTOR: License # 5815

Nearest lease or unit boundary line 450 feet.

Name C and R Drilling Co.

County Ness

City/State Denver, Colorado 80202

Lease Name Fuller Well# 1

Well Drilled For: Well Class: Type Equipment:

- Oil Swd Infield Mud Rotary
- Gas Inj Pool Ext. Air Rotary
- OWWO Expl Wildcat Cable

Domestic well within 330 feet: yes no

Municipal well within one mile: yes no

If OWWO: old well info as follows:

Operator

Well Name

Comp Date Old Total Depth

Projected Total Depth 4550 feet

Projected Formation at TD Mississippi

Expected Producing Formations Mississippi

Depth to Bottom of fresh water 450 feet

Lowest usable water formation Dakota

Depth to Bottom of usable water 900 feet

Surface pipe by Alternate: 1 2

Surface pipe to be set 350 feet

Conductor pipe if any required feet

Ground surface elevation feet MSL

This Authorization Expires 12-25-85

Approved By 6-25-85 *E. Pratt for KCO #12*

I certify that we will comply with K.S.A. 55-101, et seq., plus eventually plugging hole to K.C.C. specifications.

Production String will be cemented immediately

Date 6/25/85 Signature of Operator or Agent

Jean Arnold

Title *As Agent*

RECEIVED

Must be filed with the K.C.C. five (5) days prior to commencing well
This card void if drilling not started within six (6) months of date received by K.C.C.


JUN 25 1985

CONSERVATION DIVISION
Wichita, Kansas

Important procedures to follow :

**A Regular Section of Land
1 Mile = 5,280 Ft.**

1. Notify District office before setting surface casing.
2. Set surface casing by circulating cement to the top.
3. File completion forms ACO-1 with K.C.C. within 90 days of well completion, following instructions on ACO-1, side 1, and including copies of wireline logs.
4. Notify District office 48 hours prior to old well workover or re-entry.
5. Prior to plugging, prepare a plugging plan, then obtain agreement from the appropriate district office for an approved plugging plan.
6. Submit plugging report (CP-4) to K.C.C. after plugging is completed.
7. Obtain an approved injection docket number before disposing of salt water.
8. Notify K.C.C. within 10 days when injection commences or terminates.
9. If an alternate 2 completion, cement in the production pipe from below any usable water to surface within 120 days of spud date.

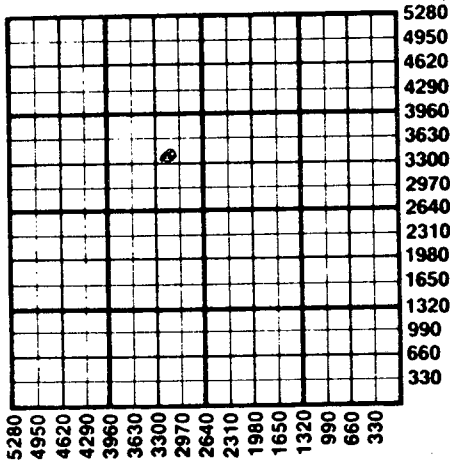

State Corporation Commission of Kansas
Conservation Division
200 Colorado Derby Building
Wichita, Kansas 67202
(316) 263-3238