


15.057.02580.0000
WELL PLUGGING RECORD

NORTH

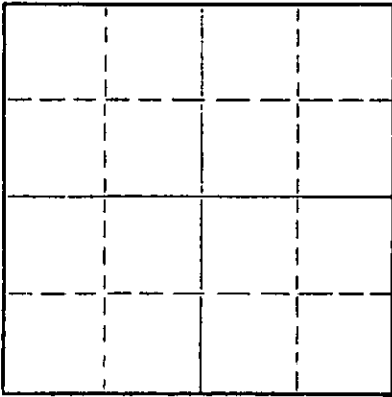

Locate well correctly on above
Section Plat

Ellis County. Sec. 3 Twp. 13 Rge. 16 (E) W (W)
Location as "NE/CNW/SW" or footage from lines SW NE SW
Lease Owner Fred Haynes Oil Co.
Lease Name Frolich Well No. B-1
Office Address Russell, Kansas
Character of Well (completed as Oil, Gas or Dry Hole) _____
Date well completed _____ 19____
Application for plugging filed _____ 19____
Application for plugging approved _____ 19____
Plugging commenced March 29 1965
Plugging completed March 30 1965
Reason for abandonment of well or producing formation _____

If a producing well is abandoned, date of last production _____ 19____
Was permission obtained from the Conservation Division or its agents before plugging was commenced? Yes

Name of Conservation Agent who supervised plugging of this well Petty
Producing formation _____ Depth to top _____ Bottom _____ Total Depth of Well 3459 Feet
Show depth and thickness of all water, oil and gas formations.

OIL, GAS OR WATER RECORDS

CASING RECORD

FORMATION	CONTENT	FROM	TO	SIZE	PUT IN	PULLED OUT

Describe in detail the manner in which the well was plugged, indicating where the mud fluid was placed and the method or methods used in introducing it into the hole. If cement or other plugs were used, state the character of same and depth placed, from surface feet for each plug set.

Sanded hole up to 3160' dump 4 sacks of cement on bottom.
Pulled pipe up to 550' circ. with mud pump 20 sacks of cement to 480', pulled pipe to 200' pump 20 sacks. Pulled pipe out put 10 sacks of cement on top.
Well completed

RECEIVED
STATE CORPORATION COMMISSION

APR 26 1965

CONSERVATION DIVISION
Wichita, Kansas

(If additional description is necessary, use BACK of this sheet)

Name of Plugging Contractor Barnes & Sons Pipe Pulling Co.
Address P.O. Box 313 Russell, Kansas

STATE OF Kansas COUNTY OF Russell, ss.
David E. Haynes (employee of owner) or (owner or operator) of the above-described well, being first duly sworn on oath, says: That I have knowledge of the facts, statements, and matters herein contained and the log of the above-described well as filed and that the same are true and correct. So help me God.

(Signature) David E. Haynes
Bx 329, Russell, Kansas (Address)

SUBSCRIBED AND SWORN to before me this 23rd day of April, 1965

My commission expires January 17, 1969

Notary Public.

DRILLERS LOG
Proellch B-1
SW SE SW 3-13-16
Ellis County, Kansas

15-051-02580-00-00

OPERATOR: Fred J. Haynes
Bldg. & Loan Bldg.
Russell, Kansas

CONTRACTOR: Haynes Drilling Company
Bldg. & Loan Bldg.
Russell, Kansas

COMMENCED: September 25, 1961

COMPLETED: October 3, 1961

CASING: 8 5/8" at 190'w/140sks
4 1/2" at 3489'125sks

I.P. - 25 BOPD

TOPS: Lsg./KC 3211 -1226
Arbuckle 3483

FORMATION:

Shale	190
Sand	475
Shale & Sand	650
Sand	750
Red Bed	1090
Anhydrite	1090-1130
Shale & Shells	1670
Shale, Lime & Shells	1800
Lime & Shale	2100
Lime	2285
Lime & Shale	2615
Shale & Lime	3058
Lime & Shale	3230
Lime	3400
Arbuckle & TD	3490

RECEIVED
STATE CORPORATION COMMISSION

MAR 11 1963

CONSERVATION DIVISION
Wichita, Kansas

I certify that the above is true and correct
to the best of my knowledge.
