


Give All Information Completely
Make Required Affidavit
Mail or Deliver Report to:
Conservation Division
State Corporation Commission
800 Bittling Building
Wichita, Kansas

15051-04791-0000
WELL PLUGGING RECORD

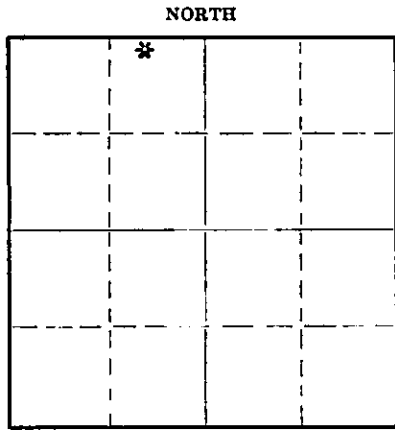

Locate well correctly on above
Section Plat

Ellis County, Sec. 32 Twp. 11S Rge. 17 (W) (W)
Location as "NE/CNW $\frac{1}{4}$ SW $\frac{1}{4}$ " or footage from lines NW NE NW
Lease Owner Great Lakes Carbon Corporation
Lease Name Hadley Well No. 1
Office Address 501 Petroleum Bldg., Wichita, Kans.
Character of Well (completed as Oil, Gas or Dry Hole) Dry Hole
Date well completed 8-31-49 19
Application for plugging filed 8-4-50 19
Application for plugging approved 8-5-50 19
Plugging commenced 8-16-50 19
Plugging completed 8-23-50 19
Reason for abandonment of well or producing formation Dry

If a producing well is abandoned, date of last production 19
Was permission obtained from the Conservation Division or its agents before plugging was commenced? Yes

Name of Conservation Agent who supervised plugging of this well Eldon Petty
Producing formation none Depth to top Bottom Total Depth of Well 3562 Feet
Show depth and thickness of all water, oil and gas formations.

OIL, GAS OR WATER RECORDS

CASING RECORD

Formation	Content	From	To	Size	Put In	Pulled Out
				8-5/8	948	none
				5-1/2	3570	2714

Describe in detail the manner in which the well was plugged, indicating where the mud fluid was placed and the method or methods used in introducing it into the hole. If cement or other plugs were used, state the character of same and depth placed, from feet to feet for each plug set.

3340 to 3325 feet Sand bridge
3325 3295 5 sacks cement
3295 260 Mudded
260 250 Rock bridge
250 205 15 sacks cement
205 35 Mud
35 30 Rock bridge
30 cellar 10 sacks cement

Plugged to specifications of State Plugger, Mr. Eldon Petty.

8-31-50

(If additional description is necessary, use BACK of this sheet)

Correspondence regarding this well should be addressed to Great Lakes Carbon Corporation
Address 501 Petroleum Bldg., Wichita, Kansas

STATE OF KANSAS, COUNTY OF SEDGWICK, ss.
I, D. H. Sholtus, Prod. Supt. (employee of owner) or (RESIDENCE ADDRESS) of the above-described well,
being first duly sworn on oath, says: That I have knowledge of the facts, statements, and matters herein contained and the log of the above-described well as filed and that the same are true and correct. So help me God.

(Signature)

D. H. Sholtus

501 Petroleum Bldg., Wichita, Kansas
(Address)

SUBSCRIBED AND SWORN to before me this 30th day of August, 1950.

My commission expires January 22, 1951

Jack G. Sheakstone
Notary Public.

PLUGGING
FILE SEC 32 Twp 11S Rge 17W
BOOK PAGE 19 LINE 35

**GABBERT DRILLING COMPANY
DRILLERS WELL LOG**

Great Lakes Carbon Corporation
Commenced - 6-9-49
Completed - 6-29-49

- Hadley #1

15:051:04771:0000

DEPTH		FORMATION	REMARKS
From	To		
0	40	Shale	
40	290	Shale, shells & Sand	
290	530	Shale & Shells	
530	565	Shale	
565	665	Sand	
665	700	Shale	
700	750	Shale, sand streaks	
750	770	Shale	
770	830	Shale	
830	900	Sand	
900	938	Red shale & shells	Run 35 jts. of 8 5/8"
938	1250	Red Shale	Surface, cemented
1250	1270	Anhydrite	with 400 sacks cement
1270	1300	Anhydrite	@ 937 feet
1300	1430	Shale & Red Bed	
1430	1500	Shale & red Bed	
1500	1595	Shale & Shells	
1595	1855	Shale	
1855	2010	Shale & Shells	
2010	2085	Shale & Shells	
2085	2135	Shale & Lime	
2135	2245	Lime	
2245	2320	Lime	
2320	2395	Lime	
2395	2495	Lime	
2495	2580	Lime	
2580 2670	2670	Lime & Shale	
2670	2755	Lime	
2755	2825	Lime	
2825	2925	Lime & Shale streaks	4 1/2" liner - Bottom 3547
2925	3030	Bro. Lime	Top 3479 1/2 cemented
3030	3100	Lime	1154 sacks cement
3100	3145	Lime	
3145	3190	Lime	
3190	3240	Lime	
3240	3270	Lime	
3270	3315	Lime	
3315	3365	Lime	
3365	3404	Lime	
3404	3460	Lime	
3460	3505	Lime	
3505	3534	Lime	
3534	3534	TD	Run 80 jts. of 5 1/2" OD and cemented with 90 sks. cement.

EXECUTED, this 5 th day of July, 1949

C. L. Gabbert
331

STATE OF KANSAS) ss ACKNOWLEDGMENT FOR INDIVIDUAL
COUNTY OF BARTON

Before me, the undersigned, a Notary Public, within and for said county and State, on this 5th day of July, 1949, personally appeared C. L. Gabbert to me personal known to be the identical person who executed the within and foregoing instrument and acknowledged to me that he executed the same as this free and voluntary act and deed for the uses and purposes therein set forth.

IN WITNESS WHEREOF, I have hereunto set my hand and official seal the day and year last above written.

My commission expires April 16, 1951

Aletha S. Fickman
NOTARY PUBLIC

FLUGGING
PAGE SEC 3274-1174
BOOK PAGE 19 LINE 35