


STATE OF KANSAS
STATE CORPORATION COMMISSION

Form CP-4

Give All Information Completely
Make Required Affidavit
Mail or Deliver Report to:
Conservation Division
State Corporation Commission
212 No. Market
Wichita, Kansas 67202

WELL PLUGGING RECORD

NORTH

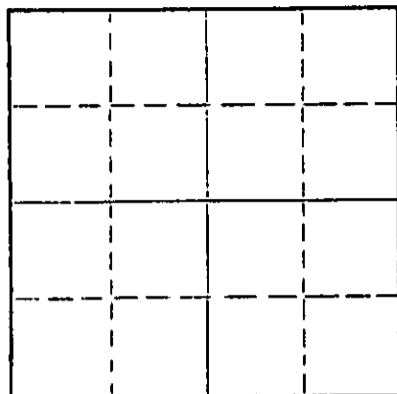

Locate well correctly on above
Section Plat

Ellis County. Sec. 36 Twp. 11S Rge. (E) 17 (W)
Location as "NE/CNWKSWK" or footage from lines SW NW NW
Lease Owner Rocket-Schusterman Oil Account
Lease Name Samuelson Well No. 7
Office Address 1209 Mid Continent Bldg., Tulsa, Okla. 74103
Character of Well (completed as Oil, Gas or Dry Hole) Dry Hole
Date well completed Feb. 21, 1970
Application for plugging filed (letter 2/24/70) Feb. 21, 1970
Application for plugging approved Feb. 21, 1970
Plugging commenced Feb. 21, 1970
Plugging completed Feb. 21, 1970
Reason for abandonment of well or producing formation

If a producing well is abandoned, date of last production 19
Was permission obtained from the Conservation Division or its agents before plugging was commenced? Yes

Name of Conservation Agent who supervised plugging of this well Leo Massey
Producing formation Depth to top Bottom Total Depth of Well 3683 Feet
Show depth and thickness of all water, oil and gas formations.

OIL, GAS OR WATER RECORDS

CASING RECORD

FORMATION	CONTENT	FROM	TO	SIZE	PUT IN	PULLED OUT
		0	252'	8-5/8"	252'	None

Describe in detail the manner in which the well was plugged, indicating where the mud fluid was placed and the method or methods used in introducing it into the hole. If cement or other plugs were used, state the character of same and depth placed, from feet to feet for each plug set.

Filled hole with heavy mud to 720 feet. Set first plug at 720 feet w/70 sacks cement.
Filled hole with heavy mud to 240 feet. Set second plug at 240 feet w/20 sacks cement.
Filled hole with heavy mud to 40 feet. Set third plug at 40 feet w/10 sacks cement.
Job complete at 2:30 AM, Feb. 21, 1970.

RECEIVED
STATE CORPORATION COMMISSION
FEB 25 1970
CONSERVATION DIVISION
Wichita, Kansas

(If additional description is necessary, use BACK of this sheet)

Name of Plugging Contractor Gabbert-Jones, Inc.
Address 830 Sutton Place, Wichita, Kansas

STATE OF Kansas, COUNTY OF Sedgwick, ss.
E. E. Hall (employee of owner) or (owner or operator) of the above-described well, being first duly sworn on oath, says: That I have knowledge of the facts, statements, and matters herein contained and the log of the above-described well as filed and that the same are true and correct. So help me God.

(Signature) E. E. Hall
830 Sutton Place, Wichita, Kansas 67202
(Address)



SUBSCRIBED AND SWORN to before me this 24 day of February, 1970
Feb. 1, 1972
Barbara J. Layton
Notary Public.

GABBERT-JONES, INC.
WICHITA, KANSAS
DRILLERS' WELL LOG

SAMUELSON #7
 SW NW NW Section 36-11S-17W
 Ellis County, Kansas

Commenced: February 12, 1970
 Completed: February 21, 1970

OPERATOR - Rocket-Schusterman Oil Account

DEPTH		FORMATION	REMARKS
From	To		
0	40	Post rock	
40	252	Shale and shells	Ran 12 joints 8-5/8" casing, set @ 252' w/200 sacks cement.
252	800	Shale	
800	1060	Shale and sand	
1060	1165	Red bed	
1165	1268	Red bed and shale	
1268	1311	Anhydrite	
1311	1650	Shale	
1650	3190	Shale and lime	
3190	3683	Lime	
3683	TD		Dry and abandoned.

RECEIVED
 STATE CORPORATION COMMISSION
 FEB 25 1970
 CONSERVATION DIVISION
 Wichita, Kansas

I, E. E. HALL, certify this is a correct copy of the Drillers' Log for the well drilled in the SW NW NW Section 36-11S-17W, Ellis County, Kansas, to the best of my knowledge and belief.

E. E. Hall

 E. E. HALL

STATE OF KANSAS)
) SS
 COUNTY OF SEDGWICK)

Before me, the undersigned, a Notary Public within and for said County and State, on this 24 day of February, 1970, personally appeared E. E. Hall to me personally known to be the identical person who executed the within and foregoing instrument and acknowledged to me that he executed the same as his free and voluntary act and deed for the uses and purposes therein set forth.

IN WITNESS WHEREOF, I have hereunto set my hand and official seal the day and year last above written.

My Commission Expires Feb. 1, 1972

Barbara J. Layton

 Barbara J. Layton, Notary Public

