

STATE OF KANSAS
STATE CORPORATION COMMISSION


WELL PLUGGING RECORD

Give All Information Completely
Make Required Affidavit
Mail or Deliver Report to:
Conservation Division
State Corporation Commission
800 Bitting Building
Wichita, Kansas

OR
FORMATION PLUGGING RECORD

Strike out upper line
when reporting plug-
ging off formations.

Ellis County. Sec. 36 Twp. 11S Rge. 17W
Location as "NE 1/4 NW 1/4 SW 1/4" or footage from lines SE 1/4 SW 1/4 NW 1/4
Lease Owner Anderson-Prichard Oil Corporation
Lease Name Samuelson Well No. 6
Office Address Orpheum Building, Wichita, Kansas
Character of Well (completed as Oil, Gas or Dry Hole) dry hole
Date well completed March 12, 1950
Application for plugging filed March 12, 1950
Application for plugging approved March 12, 1950
Plugging commenced March 12, 1950
Plugging completed March 12, 1950
Reason for abandonment of well or producing formation

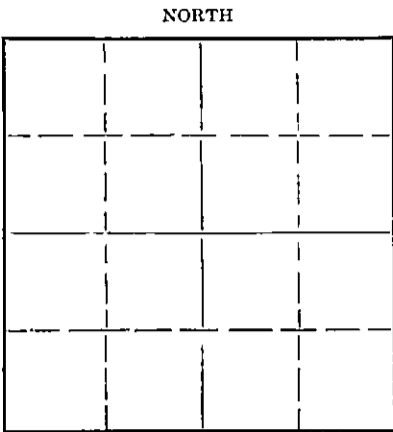

Locate well correctly on above
Section Plat

If a producing well is abandoned, date of last production 19
Was permission obtained from the Conservation Division or its agents before plugging was com-
menced? Yes
Name of Conservation Agent who supervised plugging of this well Eldon Petty, Hays, Kansas
Producing formation Depth to top Bottom Total Depth of Well Feet
Show depth and thickness of all water, oil and gas formations.

OIL, GAS OR WATER RECORDS

CASING RECORD

| Formation | Content | From | To | Size | Put In | Pulled Out |
|-----------|---------|------|-------------------|-------------|--------|-------------------|
| | | | Surface Casing | Ran 59 jts. | 1295' | 8-5/8" |
| | | | casing cemented @ | 1278' | with | 700 sacks cement. |
| | | | | | | |
| | | | | | | |
| | | | | | | |
| | | | | | | |
| | | | | | | |
| | | | | | | |
| | | | | | | |
| | | | | | | |

Describe in detail the manner in which the well was plugged, indicating where the mud fluid was placed and the method or methods used in introducing it into the hole. If cement or other plugs were used, state the character of same and depth placed, from feet to feet for each plug set.

Plugged hole with 15 sacks cement on bottom plug at 400', 10 sacks on top plug 20' below cellar.

3-27-50

(If additional description is necessary, use BACK of this sheet)

Correspondence regarding this well should be addressed to Anderson-Prichard Oil Corporation
Address

STATE OF KANSAS, COUNTY OF SEDGWICK, ss.
Richard Hindery, partner of Birmingham-Bartlett Drilling Co., contractor

being first duly sworn on oath, says: That I have knowledge of the facts, statements, and matters herein contained and the log of the above-described well as filed and that the same are true and correct. So help me God.

(Signature) Richard Hindery
300 Kaufman Building, Wichita 2, Kansas
(Address)

SUBSCRIBED AND SWORN to before me this 14th day of March 1950.

W. J. [Signature]
Notary Public.

My commission expires 22-2625 2-48-15M

36 11 170
145 1

SAMUELSON NO. 6

LOCATION: SE $\frac{1}{4}$ SW $\frac{1}{4}$ NW $\frac{1}{4}$ Sec. 36-11S-17W
Ellis County, Kansas

OPERATOR: Anderson-Prichard Oil Corporation

CONTRACTOR: Birmingham-Bartlett Drilling Co.

SURFACE CASING: Ran 59 jts., 1295' 8-5/8" casing
cemented @ 1278' with 700 sacks
cement.

OIL STRING: None. D & A.

SPUDDED: February 26, 1950

COMPLETED: March 12, 1950

LOG

(Figures indicate bottom of formation)

| | | |
|---|------|--------------------|
| 0 | 260 | Surface & shale |
| | 500 | Shale |
| | 575 | Shale and sand |
| | 775 | Sand |
| | 950 | Shale and shells |
| | 1050 | Shale and red bed |
| | 1285 | Red bed |
| | 1325 | Anhydrite |
| | 1400 | Red bed and shale |
| | 1910 | Shale and shells |
| | 1985 | Lime and shale |
| | 2100 | Lime |
| | 2200 | Shale |
| | 2420 | Lime |
| | 2640 | Shale |
| | 2865 | Shale and shells |
| | 2900 | Shale |
| | 2970 | Lime |
| | 3090 | Lime and shale |
| | 3520 | Lime |
| | 3600 | Lime and shale |
| | 3647 | Conglomerate |
| | 3719 | Conglomerate chert |
| | 3719 | Total Depth |

The undersigned Richard Hindery of the Birmingham-Bartlett Drilling Co. hereby certifies that the above is a true and correct log of the formations encountered in drilling the Samuelson No. 6 as shown on the daily drilling reports.

BIRMINGHAM-BARTLETT DRILLING CO.

BY Richard Hindery

Subscribed and sworn before me
this 14th day of March, 1950.

Richard J. Gingles
Notary Public

My commission expires November 29, 1950.