

STATE OF KANSAS
STATE CORPORATION COMMISSION

Form CP-4


WELL PLUGGING RECORD

Give All Information Completely
Make Required Affidavit
Mail or Deliver Report to:
Conservation Division
State Corporation Commission
212 No. Market
Wichita, Kansas

Ellis County, Sec. 36 Twp. 11S Rge. (E) 17W

Location as "NE/CNWxSWx" or footage from lines NE NW NE
Lease Owner High Plains Production Company
Lease Name Planters Bank Well No. 1
Office Address 304 Insurance Building, Wichita, Kansas
Character of Well (completed as Oil, Gas or Dry Hole) Dry Hole
Date well completed November 3, 1968
Application for plugging filed 19
Application for plugging approved November 3, 1968
Plugging commenced November 3, 1968
Plugging completed November 3, 1968
Reason for abandonment of well or producing formation Dry Hole

NORTH

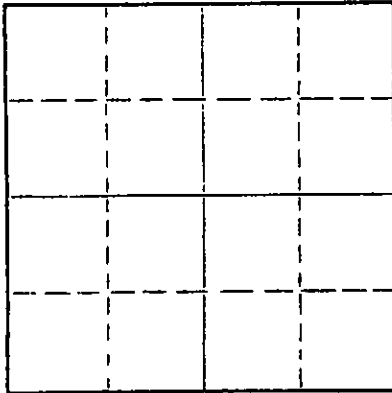

Locate well correctly on above
Section Plat

If a producing well is abandoned, date of last production 19
Was permission obtained from the Conservation Division or its agents before plugging was commenced? Yes (Leo Massey of Hays)

Name of Conservation Agent who supervised plugging of this well
Producing formation Depth to top Bottom Total Depth of Well 3639 Feet
Show depth and thickness of all water, oil and gas formations.

OIL, GAS OR WATER RECORDS

CASING RECORD

FORMATION	CONTENT	FROM	TO	SIZE	PUT IN	PULLED OUT
	Surface Casing	0	288'	8-5/8"	10/25/68	-----

RECEIVED
STATE CORPORATION COMMISSION
NOV 6 1968
CONSERVATION DIVISION
Wichita, Kansas

Describe in detail the manner in which the well was plugged, indicating where the mud fluid was placed and the method or methods used in introducing it into the hole. If cement or other plugs were used, state the character of same and depth placed, from feet to feet for each plug set.

Heavy Mud from Total Depth to 660 Feet;
Plug and 70 sax Cement thru the Drill
Pipe; Mud to 270 Feet; Plug and 20 sax
Cement thru the Drill Pipe; Mud to 40
Feet; Plug and 10 sax Cement to Base of
Cellar; 2 sax Cement in Rat Hole.
Job completed @ 8:30 A.M. on 11/3/68.


(If additional description is necessary, use BACK of this sheet)

Name of Plugging Contractor Sage Drilling Co., Inc.
Address 500 Bitting Building, Wichita, Kansas 67202

STATE OF KANSAS, COUNTY OF SEDGWICK, ss.
Wayne W., Kahmeyer of Sage Drilling Co. (employee of owner) or (owner or operator) of the above-described

being first duly sworn on oath, says: That I have knowledge of the facts, statements, and matters herein contained and the log of the above-described well as filed and that the same are true and correct. So help me God.

(Signature) Wayne W. Kahmeyer
500 Bitting Building, Wichita, Kansas
(Address)

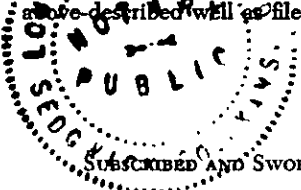

SUBSCRIBED AND SWORN TO before me this 5th day of November 19 68
Louise K. Whitted - Notary Public.

My commission expires November 26, 1970.

DRILLERS LOGPLANTERS BANK NO. 1

SURFACE CASING: OPERATOR: High Plains Production Co. DESCRIPTION:
 8-5/8" @ 288' CONTRACTOR: Sage Drilling Co., Inc. NE NW NE
 w/250 sax cement COMMENCED: October 24, 1968 Sec. 36-11S-17W
 ROTARY TOTAL DEPTH: 3639' COMPLETED: November 3, 1968 Ellis County, Kans.
 ELEVATION: 2074KB

<u>FORMATION</u>	<u>FROM</u>	<u>TO</u>	<u>REMARKS</u>
Native Rock	0	40	
Shale	40	290	
Shale & Shells	290	680	
Sand	680	885	
Shale & Red Bed	885	1249	
Anhydrite	1249	1287	
Shale	1287	1410	
Shale & Shells	1410	1920	
Shale & Lime	1920	2200	
Lime w/Shale Streaks	2200	2330	
Lime & Shale	2330	2506	
Shale & Lime	2506	2949	
Lime	2949	3025	
Lime & Shale	3025	3195	
Lime	3195	3215	
Lime & Shale	3215	3278	
Lime	3278	3639	D&A

RECEIVED
 STATE CORPORATION COMMISSION
 NOV 6 1968
 CONSERVATION DIVISION
 Wichita, Kansas

I certify that this is a true and correct copy of the above log to the best of my knowledge.

SAGE DRILLING CO., INC.

By Wayne D. Kahmeyer

Subscribed and sworn to before me this 5th day of November, 1968.



Louise K. Whitted
 Louise K. Whitted, Notary Public

My commission expires:
 November 26, 1970.