


STATE OF KANSAS  
STATE CORPORATION COMMISSION

Give All Information Completely  
Make Required Affidavit  
Mail or Deliver Report to:  
Conservation Division  
State Corporation Commission  
800 Bittling Building  
Wichita, Kansas

# WELL PLUGGING RECORD

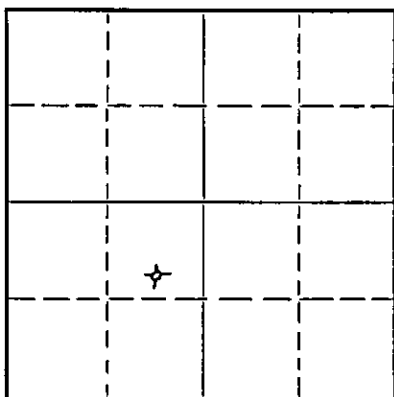

Locate well correctly on above Section Plat

Ellis County, Sec. 36 Twp. 11S Rge. 17W (E) # (W)

Location as "NE/CNW $\frac{1}{4}$ /SW $\frac{1}{4}$ " or footage from lines C S/2 NE/4 SW/4  
Lease Owner Anderson-Prichard Oil Corp.  
Lease Name Hall "C" Well No. 2  
Office Address 1000 Apco Tower, Oklahoma City, Oklahoma  
Character of Well (completed as Oil, Gas or Dry Hole) Dry Hole  
Date well completed July 5 19 51  
Application for plugging filed July 5 19 51  
Application for plugging approved July 5 19 51  
Plugging commenced July 5 19 51  
Plugging completed July 5 19 51  
Reason for abandonment of well or producing formation Dry Hole

If a producing well is abandoned, date of last production 19  
Was permission obtained from the Conservation Division or its agents before plugging was commenced? Yes

Name of Conservation Agent who supervised plugging of this well Eldon Petty  
Producing formation \_\_\_\_\_ Depth to top \_\_\_\_\_ Bottom \_\_\_\_\_ Total Depth of Well 3669 Feet  
Show depth and thickness of all water, oil and gas formations.

### OIL, GAS OR WATER RECORDS

### CASING RECORD

Formation	Content	From	To	Size	Put In	Pulled Out
		0	1265'	8 5/8	1265	None

Describe in detail the manner in which the well was plugged, indicating where the mud fluid was placed and the method or methods used in introducing it into the hole. If cement or other plugs were used, state the character of same and depth placed, from \_\_\_\_\_ feet to \_\_\_\_\_ feet for each plug set.

3669' - 241 $\frac{1}{2}$ ' - Heavy Rotary Mud  
241 $\frac{1}{2}$ ' - 240' - Rock Bridge  
240' - 177' - 20 sacks cement  
177' - 41 $\frac{1}{2}$ ' - Heavy Rotary Mud  
41 $\frac{1}{2}$ ' - 40' - Halliburton Plug and Hull Bridge  
40' - 6' - 10 sacks cement  
6 - Surface - Cellar

7-14-51

(If additional description is necessary, use BACK of this sheet)

Correspondence regarding this well should be addressed to Anderson-Prichard Oil Corp.  
Address 1000 Apco Tower, Oklahoma City, Oklahoma

STATE OF Kansas, COUNTY OF Barton, ss.  
Glenn W. Peel (employee of owner) or (~~other representative~~) of the above-described well,  
being first duly sworn on oath, says: That I have knowledge of the facts, statements, and matters herein contained and the log of the above-described well as filed and that the same are true and correct. So help me God. Glenn W. Peel

BY: Jack M. Mattick  
(Signature) P. O. Box 359  
Hoisington, Kansas (Address)

SUBSCRIBED AND SWORN TO before me this 12<sup>th</sup> day of July, 1951  
Marion M. Hester Notary Public.

My commission expires June 4, 1955

PLUGGING  
FILE SEC 36 T 11 R 17W  
BOOK PAGE 92 LINE 42

DRILLER'S LOG

Company: Anderson-Prichard Oil Corp.

C S/2 NE/4 SW/4

Sec. 36, Twp. 11S, Rge. 17W

Farm: Hall "C" Well No. 2

Total Depth: 3669'.

County: Ellis,

Kansas

Comm: 6-24-51 Comp: 7-5-51

Contractor: Glenn W. Peel

Elevation:

Casing:

8 5/8" 1265' cem.

Production: Dry

Figures below indicate bottom of formations

Hays Rock	0 -	50
Shale & Shells		620
Sand		730
Sand & Shale		770
Sand		945
Shale & Shells		1170
Red Rock		1245
Red Bed & Shells		1255
Anhydrite		1295
Shale & Shells		1970
Shale & Lime		2130
Shale		2187
Lime		2218
Broken Lime		2245
Shale & Lime		2365
Lime		2491
Shale		2588
Lime		2640
Shale		2685
Lime		2715
Shale w/lime streaks		2875
Lime & Shale		3060
Lime		3571
Conglomerate		3600
Conglomerate & Shale		3669
Total Depth		3669

This is to certify that the above information is, to the best of our knowledge, true and correct.

GLENN W. PEEL

BY: Jack MatthewsSUBSCRIBED AND SWORN to before me this 12<sup>th</sup> day of July, 1951.My commission expires June 4, 1955Marian M. Herbert  
Notary Public**PLUGGING**FILE SEC 36 T 11 R 17W  
BOOK PAGE 92 LINE 4v