


STATE OF KANSAS
STATE CORPORATION COMMISSION

Give All Information Completely
Make Required Affidavit
Mail or Deliver Report to:
Conservation Division
State Corporation Commission
212 North Market, Insurance Bldg.
Wichita, Kansas

WELL PLUGGING RECORD

Ellis County, Sec. 36 Twp. 11 Rge. 17 (E) (W)

Location as "NE/CNW/SW" or footage from lines S 1/4, 1/2, 3/4
Lease Owner Woodman & Tannitti Drilling Company
Lease Name Hall Well No. 1
Office Address 714 Union National Building, Wichita, Kansas
Character of Well (completed as Oil, Gas or Dry Hole) _____
Date well completed 9-16-1960
Application for plugging filed 9-16-1960
Application for plugging approved 9-16-1960
Plugging commenced 9-16-1960
Plugging completed 9-16-1960
Reason for abandonment of well or producing formation Dry

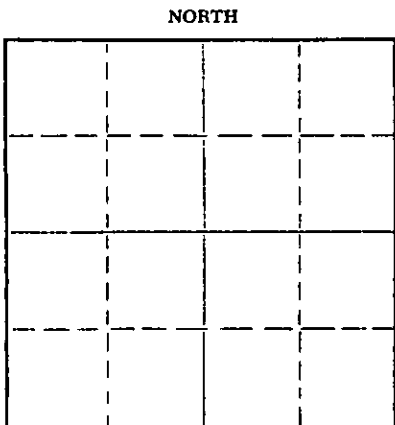

Locate well correctly on above
Section Plat

If a producing well is abandoned, date of last production _____ 19____
Was permission obtained from the Conservation Division or its agents before plugging was commenced? Yes

Name of Conservation Agent who supervised plugging of this well Eldon Petty
Producing formation _____ Depth to top _____ Bottom _____ Total Depth of Well 3078 Feet
Show depth and thickness of all water, oil and gas formations.

OIL, GAS OR WATER RECORDS CASING RECORD

FORMATION	CONTENT	FROM	TO	SIZE	PUT IN	PULLED OUT
				8 5/8"	211'	

Describe in detail the manner in which the well was plugged, indicating where the mud fluid was placed and the method or methods used in introducing it into the hole. If cement or other plugs were used, state the character of same and depth placed, from _____ feet to _____ feet for each plug set.

Bottom Plug 500' - 20 sacks
Middle Plug 200' - 15 sacks
Top Plug 40' - 10 sacks

STATE CORPORATION COMMISSION
SEP 20 1960
CONSERVATION DIVISION
Wichita, Kansas

(If additional description is necessary, use BACK of this sheet)
Name of Plugging Contractor Woodman & Tannitti Drilling Company
Address 714 Union National Building, Wichita, Kansas

STATE OF KANSAS, COUNTY OF SELWICK, ss.
K. T. Woodman (owner or operator) of the above-described well, being first duly sworn on oath, says: That I have knowledge of the facts, statements, and matters herein contained and the log of the above-described well as filed and that the same are true and correct. So help me God.

(Signature) K. T. Woodman
714 Union National Bldg., Wichita 2, Kansas
(Address)

SUBSCRIBED AND SWORN TO before me this 19th day of September, 1960

My Commission Expires Sept. 21, 1961
My commission expires _____
MILDRED M. PAGE Notary Public.



DRILLING LOG

Company: Woodman & Iannitti Drilling Company
 Lease: #1 HALL SW NW SE 36-11-17W
 Ellis County, Kansas
 Contractor: Woodman & Iannitti Drilling Company
 714 Union National Building
 Wichita, Kansas
 Date Commenced: 9-6-60
 Date Completed: 9-16-60
 Total Depth: 3678'
 Casing: 8 5/8" - 211' with 130 sacks cement

Figures Indicate the Bottom of the Formation

0-126 Rock & Clay	1885 Shale & Shells
615 Shale	2030 Broken Lime
800 Sand	2660 Lime
1140 Shale & Red Bed	3065 Shale & Lime
1280 Red Bed	3625 Lime
1320 Anhydrite	3678 Arbuckle
1485 Red Bed & Shale	

GEOLOGICAL TOPS

Elevation	2093 RB
Anhydrite	1280
Heebner	3267
Toronto	3287
Lansing	3316
Conglomerate	3581
Arbuckle	3618
Total Depth	3678

I certify the above to be a true and correct copy of the Driller's Log and the geological tops to the best of my knowledge and belief.

WOODMAN & IANNITTI DRILLING COMPANY

By: K. T. Woodman
 K. T. Woodman

RECEIVED
 STATE CORPORATION COMMISSION

SEP 20 1960

CORPORATION DIVISION