


Give All Information Completely
Make Required Affidavit
Mail or Deliver Report to:
Conservation Division
State Corporation Commission
211 No. Broadway
Wichita, Kansas

WELL PLUGGING RECORD

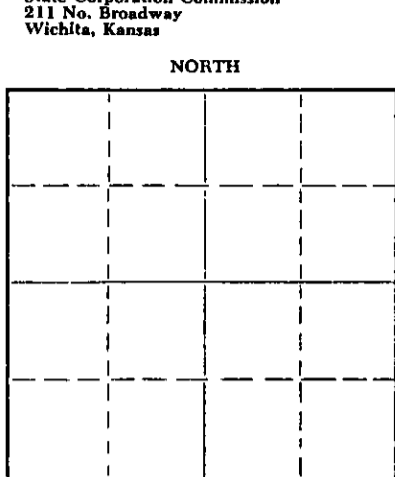

Locate well correctly on above
Section Plat

Ellis County, Sec. 3 Twp. 11 Rge. (E) 18 (W)
Location as "NE/CNWxSWx" or footage from lines NW NE SW
Lease Owner American Petrofina Company of Texas
Lease Name Meistrell Well No. 1
Office Address Box 209 Russell, Kansas
Character of Well (completed as Oil, Gas or Dry Hole) oil
Date well completed February 20 19 49
Application for plugging filed July 28 19 59
Application for plugging approved July 28 19 59
Plugging commenced July 30 19 59
Plugging completed July 30 19 59
Reason for abandonment of well or producing formation Insufficient Production

If a producing well is abandoned, date of last production May 24 19 59
Was permission obtained from the Conservation Division or its agents before plugging was commenced? yes

Name of Conservation Agent who supervised plugging of this well Mr. Eldon Petty
Producing formation _____ Depth to top _____ Bottom _____ Total Depth of Well 2530 feet
Show depth and thickness of all water, oil and gas formations.

OIL, GAS OR WATER RECORDS

CASING RECORD

FORMATION	CONTENT	FROM	TO	SIZE	PUT IN	PULLED OUT
				8 5/8	165'	0
				5 1/2	3531	0

Describe in detail the manner in which the well was plugged, indicating where the mud fluid was placed and the method or methods used in introducing it into the hole. If cement or other plugs were used, state the character of same and depth placed, from _____ feet to _____ feet for each plug set.

PUMPED 40 sacks of mud in hole
PUMPED 80 sacks of cement in hole.

RECEIVED
STATE CORPORATION COMMISSION
AUG 10 1959
CONSERVATION DIVISION
Wichita, Kansas

(If additional description is necessary, use BACK of this sheet)
Name of Plugging Contractor C. E. Shull Casing Pulling Company
Address Box 558 Great Bend, Kansas

STATE OF KANSAS, COUNTY OF RUSSELL, ss.
VERREL J. BRACK (employee of owner) or ~~CONTRACTOR~~ of the above-described well, being first duly sworn on oath, says: That I have knowledge of the facts, statements, and matters herein contained and the log of the above-described well as filed and that the same are true and correct. So help me God.

(Signature) Verrel J. Brack
Box 209 (Address) RUSSELL, KANSAS

SUBSCRIBED AND SWORN TO before me this 7th day of August, 1959

My commission expires 10-2-60 Carroll J. Bennett Notary Public.

PLUGGING
 FILE SEC. 3 T. 11 R. 18W
 BOOK PAGE 53 LINE 28

Company: El Dorado Refining Co. etal
(American Petrofina Company of Texas)

Sec. 3 T. 11s R. 18w

Farm: Meistrell No. 1

Loc. NW NE SW

Total Depth: 3536

County: Ellis

Commenced: 1-30-49

Completed: 2-20-49

Contractor: Flournoy & Williams

Issued: 3-14-49

Casing:

8 5/8" 165'

5 1/2" 3531'

(Figures Indicated bottom of formations)

Blue Shale	65
Sand	90
Shale and shells	775
Shale and sand	1220
Red Beds	1305
Anhydrite	1330
Red Rock	1640
Shale	1730
Salt	1810
Shale and Shells	2445
Lime and shale	2675
Shale and shells	2750
Shale and Lime	3057
Lime	3171
Lime and Shale	3190
Lime	3536

DST 3536 Rec. 90' oil and oil cut mud -
no water.
Drilled Plug
Fillup of 650' oil 6 hrs.
Swabbed 25.1 bbls. 9 hrs.

Tops

Topeka	2923
Heebner Shale	3171
Lansing	3206
Conglomerate	3457
Simpson	3514
Arbuckle	3531

STATE OF KANSAS)
COUNTY OF SEDGWICK) SS

Chester Williams of lawful age, being first duly sworn under oath states that the above is a true copy of the log of the above well.

/s/ Chester Williams

Subscribed and sworn to this 14th day of March, 1949.

/x/ Nola Babb
Notary Public

My Commission Expires Nov. 3, 1952

PLUGGING
FILE SEC. 3 T. 11 R. 18w
BOOK PAGE 53 LINE 28

Brief Plugging Record on
American Petrofina Co. of Texas's
Meistrell Well #1, in
Ellis County, Kansas

Total depth 3536'

5½" casing set at 3531'

8 5/8" casing set at 165'

Pumped 40 sacks of mud in hole

Pumped 80 sacks of cement in hole

Well plugged July 30, 1959

C. E. Shull Casing Pulling Company
Box 558
Great Bend, Kansas

License No. 8

RECEIVED
COMMISSION
JUL 10 1959
CONSERVATION DIVISION
Topeka, Kansas

PLUGGING			
FILE	SEC. 3	T. 11	R. 84
BOOK	PAGE 53	LINE	28