

15-101-20727-00-00


STATE OF KANSAS
STATE CORPORATION COMMISSION

WELL PLUGGING RECORD

Give All Information Completely
Make Required Affidavit
Mail or Deliver Report to
Conservation Division
State Corporation Comm.
245 North Water
Wichita, KS 67202

Location as NE/CNW $\frac{1}{4}$ /SW $\frac{1}{4}$ or footage from lines _____
NW-SE SE-NW-NE

Lease Owner Palomino Petroleum
Lease Name Mendenhall Well No. 5
Office Address P. O. Box 18610, Wichita, Kansas 67218
Character of Well (Completed as Oil, Gas or Dry Hole) Dry Hole

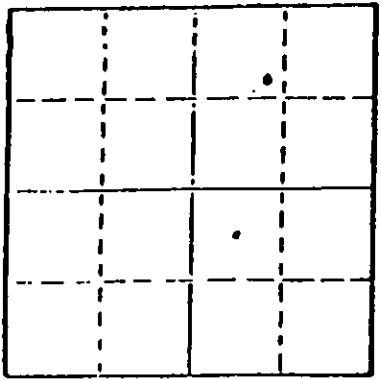

Locate well correctly on above Section Plat

Date Well completed November 30, 1982
Application for plugging filed December 30, 1982
Application for plugging approved December 30, 1982
Plugging commenced December 30, 1982
Plugging completed December 30, 1982
Reason for abandonment of well or producing formation Dry Hole

If a producing well is abandoned, date of last production 19

Was permission obtained from the Conservation Division or its agents before plugging was commenced? Yes

Name of Conservation Agent who supervised plugging of this well Bob Tarbottom
Producing formation _____ Depth to top _____ Bottom _____ Total Depth of Well _____
Show depth and thickness of all water, oil and gas formations.

OIL, GAS OR WATER RECORDS

CASING RECORD

FORMATION	CONTENT	FROM	TO	SIZE	PUT IN	PULLED OUT

Describe in detail the manner in which the well was plugged, indicating where the mud fluid was placed and the method or methods used in introducing it into the hold. If cement or other plugs were used, state the character of same and depth placed, from _____ feet to _____ feet for each plug set.

Plugged: w/ 70 sks @ 1800'
50 sks @ 360'
10 sks @ 40' Halls & Plug
10 sks RH, 10 Sks MH Cement: 50-50 Pozmix, 2% Gel, 3% CC.

(If additional description is necessary, use BACK of this sheet)

Name of Plugging Contractor Allied

STATE OF Kansas COUNTY OF Sedgwick, ss.
Jerome D. Marcus (employee of owner) or (owner or operator)

of the above-described well, being first duly sworn on oath, says: That I have knowledge of the facts, statements, and matters herein contained and the log of the above-described well as filed and that the same are true and correct. So help me God.

(Signature) [Signature]
401 E. Douglas, Suite 402, Wichita, Kansas 67202
(Address)

SUBSCRIBED AND SWORN TO before me this 13th day of December, 19 82

My commission expires 6-8-85

Cheryl L. Bengit
Notary Public.

RECEIVED
STATE CORPORATION COMMISSION

JAN 04 1983

CONSERVATION DIVISION
Wichita Kansas



DRILLERS LOG

MENDENHALL #5

15-101-20727-00-00

NW NE
Sec. 3-16S-27W
Lane, Ks.

RECEIVED
STATE CONSERVATION COMMISSION
JAN 03 1983
CONSERVATION DIVISION
Wichita, Kansas

Company: Palomino Petroleum

Contractor: BEREDCO INC.

Comm: 11/23/82

Comp.: 11/30/82

Casing: set 8 jts., new 24#, 8-5/8" Set @ 327' w/ 200 sks 60-40 Pozmix, 2% Gel, 3% CC
Did Circ. PD @ 10:30 PM 11/23/82 by Allied.

<u>FORMATION</u>	<u>FROM</u>	<u>TO</u>
Post Rock	0	335
Shale & Sand	335'	1180
Shale & Sand & Anhydrite	1180'	2025'
Shale	2025'	2535'
Lime & Shale	2535'	4130'
Lime	4130'	4365'
Lime & Shale	4365'	4455'
Lime	4455'	4500'
TOTAL ROTARY DEPTH 4500'		

RECEIVED
STATE CONSERVATION COMMISSION
JAN 02 1983
CONSERVATION DIVISION
Wichita, Kansas


STATE OF KANSAS

ss:

COUNTY OF SEDGWICK

I certify that this is a true and correct copy of the above log as shown by the drilling reports.

BEREDCO

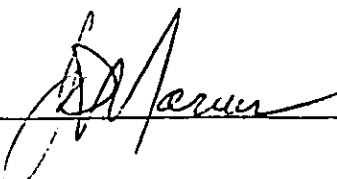

Subscribed and sworn to before me this 13th day of December, 1982.

