


Give All Information Completely
Make Required Affidavit
Mail or Deliver Report to:
Conservation Division
State Corporation Commission
P. O. Box 17027
Wichita, Kansas 67217
NORTH

WELL PLUGGING RECORD

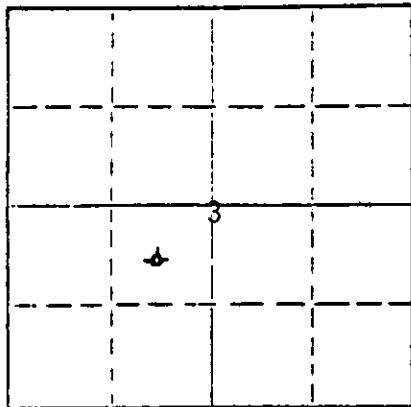

Locate well correctly on above Section Plat

Lane _____ County. Sec. 3 Twp. 16S Rge. _____ (E) 27W (W)
Location as "NE/CNW/SW" or footage from lines _____ NE SW
Lease Owner DONALD C. SLAWSON
Lease Name Mendenhall 'I' Well No. 2
Office Address 200 Douglas Building Wichita, Kansas 67202
Character of Well (completed as Oil, Gas or Dry Hole) Dry Hole
Date well completed February 16, 1982
Application for plugging filed February 16, 1982
Application for plugging approved February 16, 1982
Plugging commenced February 16, 1982
Plugging completed February 16, 1982
Reason for abandonment of well or producing formation Dry Hole

If a producing well is abandoned, date of last production _____ 19____
Was permission obtained from the Conservation Division or its agents before plugging was commenced? Yes

Name of Conservation Agent who supervised plugging of this well Gilbert Balthazor
Producing formation _____ Depth to top _____ Bottom _____ Total Depth of Well 4530 Feet
Show depth and thickness of all water, oil and gas formations.

OIL, GAS OR WATER RECORDS

CASING RECORD

FORMATION	CONTENT	FROM	TO	SIZE	PUT IN	PULLED OUT
		surface	365'	8 5/8"		

Describe in detail the manner in which the well was plugged, indicating where the mud fluid was placed and the method or methods used in introducing it into the hole. If cement or other plugs were used, state the character of same and depth placed, from _____ feet to _____ feet for each plug set.

1st plug @ 900' w/70 sx
2nd plug @ 360' w/40 sx
Bridge @ 40' w/10 sx
10 sx in Rat Hole

RECEIVED
STATE CORPORATION COMMISSION
APR 21 1982
CONSERVATION DIVISION
Wichita, Kansas

Name of Plugging Contractor Sun Oil Well Cementing Co., Inc.
Address Box 169 Great Bend, Kansas 67530

STATE OF KANSAS COUNTY OF SEDGWICK ss.
William R. Horigan (employee of owner) or (owner or operator) of the above-described

well, being first duly sworn on oath, says: That I have knowledge of the facts, statements, and matters herein contained and the log of the above-described well as filed and that the same are true and correct. So help me God.

SHERRY L. KENDALL
STATE NOTARY PUBLIC
Sedgwick County, Kansas
My Appt. Exp. 6/12/82

(Signature) William R. Horigan
William R. Horigan

200 Douglas Building (Address) Wichita, Kansas 67202
April 12th 1982

SUBSCRIBED AND SWORN to before me this _____ day of _____ 1982

Sherry L. Kendall
Sherry L. Kendall Notary Public.

My commission expires 06/12/82