

STATE OF KANSAS
STATE CORPORATION COMMISSION

WELL PLUGGING RECORD


OR

FORMATION PLUGGING RECORD

Strike out upper line
when reporting plug-
ging off formations.

Give All Information Completely
Make Required Affidavit
Mail or Deliver Report to:
Conservation Division
State Corporation Commission
800 Bittling Building
Wichita, Kansas

NORTH

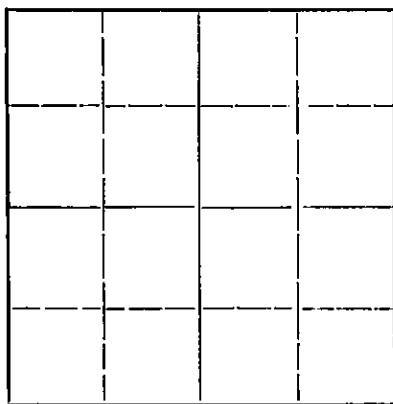

Locate well correctly on above
Section Plat

Rice County. Sec. 10 Twp. 21 Rgc. (E) 9 (W)
Location as "NE 1/4 NW 1/4 SW 1/4" or footage from lines. S 1/2 SW 1/4 NW 1/4
Lease Owner Simpson Oil Company & Alpine Oil & Royalty Co., Inc.
Lease Name Fair Well No. 1
Office Address 713 First Nat'l. Bldg., Wichita, Kansas
Character of Well (completed as Oil, Gas or Dry Hole) Dry
Date, well completed 10-7 19 40
Application for plugging filed 10-16 19 40
Application for plugging approved 10-17 19 40
Plugging Commenced 10-17 19 40
Plugging Completed 10-17 19 40
Reason for abandonment of well or producing formation Dry hole

If a producing well is abandoned, date of last production 19
Was permission obtained from the Conservation Division or its agents before plugging was com-
menced? Yes

Name of Conservation Agent who supervised plugging of this well Alexander
Producing formation Depth to top 3382 Bottom 3390 Total Depth of Well 3390 Feet
Show depth and thickness of all water, oil and gas formations.

OIL, GAS OR WATER RECORDS

CASING RECORD

Formation	Content	From	To	Size	Put In	Pulled Out
				8 5/8"	202'	0
				5 1/2"	3282	2800

Describe in detail the manner in which the well was plugged, indicating where the mud fluid was placed and the method or methods used in introducing it into the hole. If cement or other plugs were used, state the character of same and depth placed, from feet to feet for each plug set.

Well was filled with rotary mud from 3390' to 202', cement plug from 202' to 187', rotary mud from 187' to 12', cement plug from 12' to 6' bottom of cellar

FILE 10 21 9W
BOOK PAGE 119 34

10-23-40

(If additional description is necessary, use BACK of this sheet)

Correspondence regarding this well should be addressed to Simpson Oil Company
Address 713 First Nat'l. Bldg., Wichita, Kansas

STATE OF Kansas COUNTY OF Sedgwick ss.
Sam Payne, Jr. (employer or owner) or (owner or operator) of the above-described well,
being first duly sworn on oath, says: That I have knowledge of the facts, statements, and matters herein contained and the log of the above-described well as filed and that the same are true and correct. So help me God.

(Signature) [Signature]
713 First Nat'l. Bldg., Wichita, Kansas
(Address)

SUBSCRIBED AND SWORN to before me this 22nd day of October, 19 40.

My commission expires March 30, 1944.

[Signature] Notary Public.



FAIR WELL NO. 1

Alpine Oil & Royalty Co., Inc. and Simpson Oil Company
 Center S 1/2 SE 1/4 NW 1/4 10-218-9W, Rice County, Kansas
 Commenced: 8-14-40
 Completed: 10-7-40

ROTARY
 Dry

Log

Sand	70
Red bed	225
(10 3/4" @ 95)	
(8 5/8" @ 205)	
Anhydrite	269
Sable & shells	734
Shale	795
Salt & shale	1090
Shale	1097
Shale & shells	1251
Lime, broken	1956
Shale & lime	2167
Lime, broken	2640
Lime	2743
Lime, broken	2808
Lime	2830
Shale & shells	2897
Lime, broken	2912
Shale	2948
Lime, broken	2975
Lime	3032
Lime, broken	3042
Lime	3235
Shale & shells	3270
Conglomerate	3330
Lime	3374
Green shale	3380
(5 1/2" @ 3382)	
Sand	3388
Total Depth	3388

TOPS

Anhydrite	225
Topeka	2745
Lansing	2948
Small S. O.	2900
Small S. O.	3030-35
Conglomerate	3230
Viola	3330
Simpson	3374
Total Depth	3388
Show Oil & Gas--Hole Full Water	

10 21 9W
 119 line 34

OCT 23 1940
 RICE COUNTY, KANSAS
 10-23-40