


Give All Information Completely
Make Required Affidavit
Mail or Deliver Report to:
Conservation Division
State Corporation Commission
211 No. Broadway
Wichita, Kansas

WELL PLUGGING RECORD

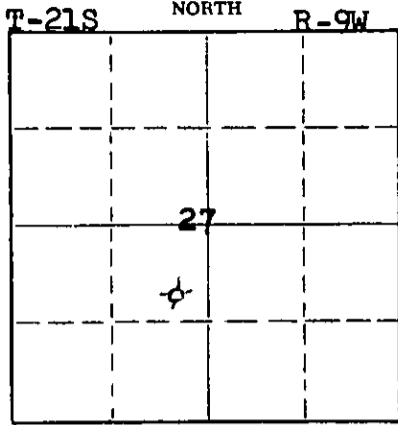

Locate well correctly on above Section Plat

Rice County, Sec 27 Twp 21 Rge. 9 (E) 9 (W)
Location as "NE/CNW/SW" or footage from lines SE NE SW
Lease Owner Donald T. Ingling et al
Lease Name J. Fair Well No. 1
Office Address 615 First Nat'l Bank Bldg., Wichita 2
Character of Well (completed as Oil, Gas or Dry Hole) Dry Hole
Date well completed August 12, 1960
Application for plugging filed August 12, 1960
Application for plugging approved August 12, 1960
Plugging commenced August 12, 1960
Plugging completed August 13, 1960
Reason for abandonment of well or producing formation dry

If a producing well is abandoned, date of last production 19
Was permission obtained from the Conservation Division or its agents before plugging was commenced? Yes

Name of Conservation Agent who supervised plugging of this well Gilbert Toman
Producing formation _____ Depth to top _____ Bottom _____ Total Depth of Well 3460 Feet
Show depth and thickness of all water, oil and gas formations.

OIL, GAS OR WATER RECORDS

CASING RECORD

FORMATION	CONTENT	FROM	TO	SIZE	PUT IN	PULLED OUT
				8 5/8"	150'	None

Describe in detail the manner in which the well was plugged, indicating where the mud fluid was placed and the method or methods used in introducing it into the hole. If cement or other plugs were used, state the character of same and depth placed, from _____ feet to _____ feet for each plug set.

Circulated one and one-half hours, filled hole with heavy mud, laid down drill pipe except three joints, then picked up drill pipe again and ran to bottom and plugged hole in stages (request CITIES SERVICE GAS COMPANY) - spotted cement through drill pipe as follows;

- 40 sacks from 3460 to 3340
- 15 sacks from 1225 to 1175
- 15 sacks from 750 to 700
- 20 sacks from 200 to 130
- 10 sacks from 40 to 10
- 2 sacks in rathole

STATE CORP. COM.
AUG 17 1960
08-17-60

(If additional description is necessary, use BACK of this sheet)

Name of Plugging Contractor Donald T. Ingling
Address 615 First National Bank Bldg., Wichita 2, Kansas

STATE OF KANSAS, COUNTY OF SEDGWICK, ss.
D. T. Ingling (employee of owner) or (owner or operator) of the above-described well, being first duly sworn on oath, says: That I have knowledge of the facts, statements, and matters herein contained and the log of the above-described well as filed and that the same are true and correct. So help me God.

(Signature) [Signature]
615 First Nat'l Bank Bldg., Wichita 2
(Address)

SUBSCRIBED AND SWORN TO before me this 15th day of August, 19 60

[Signature]

My commission expires Feb. 27, 1964

Notary Public.



Donald T. Ingling et al, Lease Owner

Section 27-21S-9W

Donald T. Ingling, Contractor

Location: SE NE SW

Commenced: 8-2-60
Completed: 8-13-60

County: Rice

Total Depth: 3460'

Production: Dry

Casing: 8 5/8" 150' (90 sacks cement)

Elevation: 1670 RB

Figures below indicate bottom formation

85	sand	3306	lime
150	shale and shells	3330	Conglomerate
610	red rock shale	3390	shale - conglomerate
800	shale and salt	3420	Conglomerate
900	shale and shells	3439	Conglomerate
1215	shale and shells	3455	sand - Misner
1250	lime and sand	3460	sand - Misner
1410	lime	3460	Total Depth
1590	lime		
1690	lime		
1785	lime and shale		
1985	lime and shale		
2210	lime and shale		
2265	lime and shale		
2310	lime		
2480	lime		
2550	lime and shale		
2620	lime		
2705	lime		
2795	lime		
2824	lime		
2829	Haebner		
2910	shale and sand		
2962	sand and shale		
2965	lime - Brown		
2990	shale		
3010	lime - Lansing		
3058	lime		
3145	lime		
3215	lime		
3265	lime		
3278	lime		

I certify this is a true and correct copy of the above mentioned well.

STATE OF KANSAS)

SEDGWICK COUNTY) ss.

Subscribed and sworn to before me, a Notary Public, in said county and state



 Notary Public

My commission expires: Feb. 27, 1964