


STATE OF KANSAS  
STATE CORPORATION COMMISSION

Form CP-4

Give All Information Completely  
Make Required Affidavit  
Mail or Deliver Report to:  
Conservation Division  
State Corporation Commission  
212 No. Market  
Wichita, Kansas 67202

WELL PLUGGING RECORD

NORTH

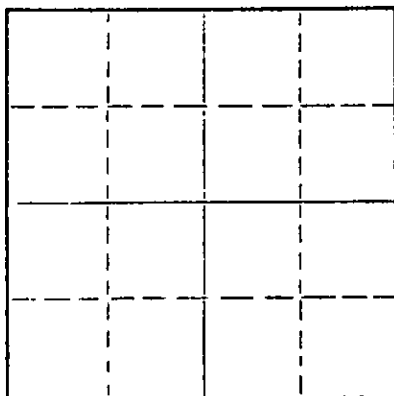

Locate well correctly on above  
Section Plat

Rice County. Sec. 28 Twp. 21 Rge. 9 (E) 9 (W)  
Location as "NE/CNW/SW" or footage from lines CE/2 SW SW  
Lease Owner Robert D. Holliday  
Lease Name Wellman Well No. 1  
Office Address 38 Walnut Plaza, Great Bend, Kansas  
Character of Well (completed as Oil, Gas or Dry Hole) Dry Hole  
Date well completed October 13, 1970  
Application for plugging filed October 13, 1970  
Application for plugging approved October 13, 1970  
Plugging commenced October 13, 1970  
Plugging completed October 13, 1970  
Reason for abandonment of well or producing formation Dry

If a producing well is abandoned, date of last production 19  
Was permission obtained from the Conservation Division or its agents before plugging was commenced? Yes

Name of Conservation Agent who supervised plugging of this well Gilbert Toman  
Producing formation \_\_\_\_\_ Depth to top \_\_\_\_\_ Bottom \_\_\_\_\_ Total Depth of Well 3601 Feet  
Show depth and thickness of all water, oil and gas formations.

OIL, GAS OR WATER RECORDS

CASING RECORD

FORMATION	CONTENT	FROM	TO	SIZE	PUT IN	PULLED OUT
				8 5/8	211'	

Describe in detail the manner in which the well was plugged, indicating where the mud fluid was placed and the method or methods used in introducing it into the hole. If cement or other plugs were used, state the character of same and depth placed, from \_\_\_\_\_ feet to \_\_\_\_\_ feet for each plug set.

Bottom plug @ 200' w/25 sx.  
Top plug @ 40' w/10 sx.

RECEIVED  
STATE CORPORATION COMMISSION  
OCT 19 1970  
CONSERVATION DIVISION  
Wichita, Kansas

(If additional description is necessary, use BACK of this sheet)  
Name of Plugging Contractor Woodman & Iannitti Drilling Company  
Address 706 Union National Building

STATE OF KANSAS, COUNTY OF SEDGWICK, ss.

K. T. WOODMAN (employee of owner) or (owner or operator) of the above-described well, being first duly sworn on oath, says: That I have knowledge of the facts, statements, and matters herein contained and the log of the above-described well as filed and that the same are true and correct. So help me God.

(Signature) K. T. Woodman  
706 Union National Building  
(Address)

SUBSCRIBED AND SWORN to before me this 16th day of October, 19 70

My commission expires Feb. 11, 1972

Justina Chamberlain  
Justina Chamberlain  
Notary Public.

K. T. WOODMAN  
REG. PHONE AM 5-3572  
OFFICE PH. AM 5-7650  
WICHITA, KANSAS

15-159-20774-0000 D. J. IANNITTI  
TELEPHONE 653-2381  
HOISINGTON, KANSAS

**WOODMAN & IANNITTI DRILLING COMPANY**  
*Rotary Drilling Contractors*

706 UNION NATIONAL BUILDING  
WICHITA, KANSAS 67202

October 16, 1970

Company;	Robert D. Holliday
Lease;	Wellman #1
Location;	CE/2 SW SW
Section;	28-21-9W
County;	Rice
Comm;	October 5, 1970
Compl;	October 13, 1970
Total Depth;	3601'
Casing;	8 5/8" @ 211' w/200 sx
Production;	D & A

Figures Indicate Bottom Of Formations;

100	Sand
211	Red Bed
350	Shale
860	Shale & Shells
1100	Shale & Shells
1320	Lime
1600	Lime
1765	Shale & Lime
2090	Lime
2410	Lime & Shale
2540	Shale
2680	Lime
2800	Lime
2876	Lime
3025	Shale & Lime
3130	Lime
3192	Lime
3227	Lime
3278	Lime
3309	Lime
3370	Lime & Shale
3383	Lime
3455	Lime
3520	Lime
3544	Lime & Sand
3575	Lime
3601	Total Depth

RECEIVED  
STATE CORPORATION COMMISSION  
OCT 19 1970  
CONSERVATION DIVISION  
Wichita, Kansas

I certify the above to be a true and correct copy of the driller's log and the geological tops to the best of my knowledge and belief.

Woodman & Iannitti Drilling Co.

*K. T. Woodman*  
K. T. Woodman