


STATE OF KANSAS  
STATE CORPORATION COMMISSION

Form CP-4

Give All Information Completely  
Make Required Affidavit  
Mail or Deliver Report to:  
Conservation Division  
State Corporation Commission  
212 No. Market  
Wichita, Kansas 67202

WELL PLUGGING RECORD

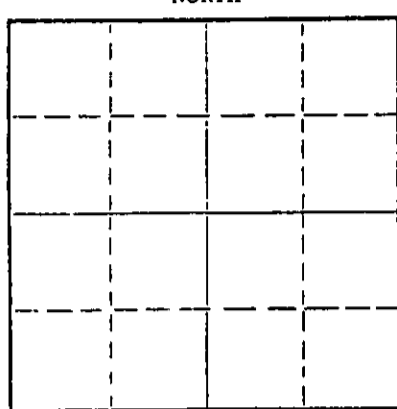

Locate well correctly on above  
Section Plat

RICE County, Sec 28 Twp 21S Rge. (E) 9 (W)  
Location as "NE/CNWSW" or footage from lines SE SW NE SW 21S 28E  
Lease Owner Lebsack Production, Inc.  
Lease Name Wellman Well No. 1  
Office Address P. O. Box 489, Hays, Kansas 67601  
Character of Well (completed as Oil, Gas or Dry Hole) Dry Hole  
Date well completed 7-25 19 71  
Application for plugging filed 7-25 19 71  
Application for plugging approved 7-25 19 71  
Plugging commenced 7-25 19 71  
Plugging completed 7-25 19 71  
Reason for abandonment of well or producing formation D & A

If a producing well is abandoned, date of last production 19  
Was permission obtained from the Conservation Division or its agents before plugging was commenced? Yes

Name of Conservation Agent who supervised plugging of this well Gilbert Tolman  
Producing formation \_\_\_\_\_ Depth to top \_\_\_\_\_ Bottom \_\_\_\_\_ Total Depth of Well 3540 Feet  
Show depth and thickness of all water, oil and gas formations.

OIL, GAS OR WATER RECORDS

CASING RECORD

FORMATION	CONTENT	FROM	TO	SIZE	PUT IN	PULLED OUT
Surface soil		0	248	8 5/8	7-17-71	

Describe in detail the manner in which the well was plugged, indicating where the mud fluid was placed and the method or methods used in introducing it into the hole. If cement or other plugs were used, state the character of same and depth placed, from \_\_\_\_\_ feet to \_\_\_\_\_ feet for each plug set.

Fill hole w/heavy mud to 240 feet. Set 1st Plug  
1/2 sax hulls and 25 sax cement. Fill hole w/heavy mud  
to 40 Ft. Set 2nd Plug w 1/2 sax hulls and 10 sax cement to  
Botton of Cellar. Bridge rat hole w/2 sax cement.

RECEIVED  
STATE CORPORATION COMMISSION  
AUG 12 1971  
CONSERVATION DIVISION  
Wichita, Kansas  
08-12-71


(If additional description is necessary, use BACK of this sheet)

Name of Plugging Contractor GABBERT-JONES, INC.  
Address 830 Sutton Place, Wichita, Kansas

STATE OF KANSAS, COUNTY OF Sedgwick, ss.  
Jack W. Gabbert (employee of owner) or (~~OWNER OR OPERATOR~~) of the above-described well, being first duly sworn on oath, says: That I have knowledge of the facts, statements, and matters herein contained and the log of the above-described well as filed and that the same are true and correct. So help me God.

(Signature) [Signature]  
830 Sutton Place, Wichita, Kansas  
(Address)

Subscribed and sworn to before me this 11th day of August 19 71

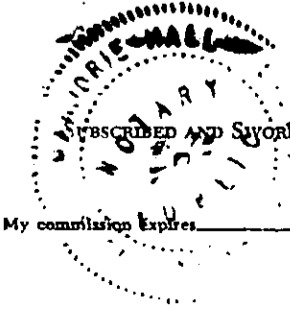

Marjorie Hall  
Notary Public.

GABBERT-JONES, INC.  
WICHITA, KANSAS  
DRILLERS' WELL LOG

WELLMAN #1  
SE SW NW Section 28-218-9W  
Rice County, Kansas

Commenced: July 18, 1971  
Completed: July 25, 1971

RECEIVED  
STATE COMMISSION  
AUG 12 1971  
CONSERVATION DIVISION  
Wichita, Kansas

OPERATOR: LESSACK OIL PRODUCTION, INC.

DEPTH		FORMATION	REMARKS
From	To		
0	53	Sand	Ran 6 joints New 20# 8 5/8" casing set @ 248' w/200 sks Sunset 2 1/2 Gal P.D. 2:45 AM 7/17/71 Cement Cir. Job by Sun
53	130	Redbed	
130	685	Shale	
685	1705	Shale - Lime	
1705	2866	Lime-Shale	
2866	2957	Sand-Shale	
2957	3025	Lime	
3025	3160	Lime & Shale	
3160	3520	Lime	
3520	3840	Lime & Shale	
3840	TD		

Dry and Abandoned


I, James S. Sutton II, certify this is a correct copy of the Drillers' Log for the well drilled in the SE SW NW, Sec. 28-218-9W, Rice County, Kansas, to the best of my knowledge and belief.

*James S. Sutton II*  
James S. Sutton II

STATE OF KANSAS        )  
                                  ) SS  
COUNTY OF SEDGWICK )

Before me, the undersigned, a Notary Public within and for said County and State, on this 28th day of July, 1971, personally appeared James S. Sutton II to me personally known to be the identical person who executed the within and foregoing instrument and acknowledged to me that he executed the same as his free and voluntary act and deed for the uses and purposes therein set forth.

IN WITNESS WHEREOF, I have hereunto set my hand and official seal the day and year last above written.

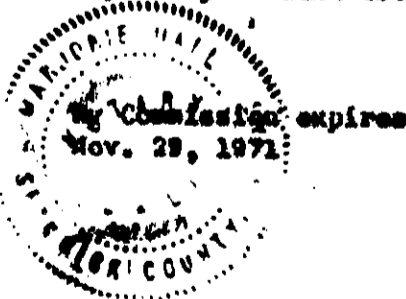

*Marjorie Hall*  
Marjorie Hall, Notary Public