


STATE OF KANSAS  
STATE CORPORATION COMMISSION

Give All Information Completely  
Make Required Affidavit  
Mail or Deliver Report to:  
Conservation Division  
State Corporation Commission  
211 No. Broadway  
Wichita, Kansas

WELL PLUGGING RECORD

NORTH

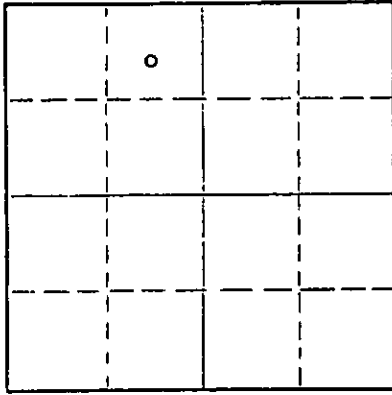

Locate well correctly on above Section Plat

Rice County. Sec. 34 Twp. 21S Rge. 9W (E) (W)  
Location as "NE/CNW&SW&" or footage from lines C NE NW  
Lease Owner Kern Drilling Company, Inc.  
Lease Name Plush Well No. 1  
Office Address 337 Union Center, Wichita, Kansas 67202  
Character of Well (completed as Oil, Gas or Dry Hole) Dry Hole  
Date well completed February 13 19 67  
Application for plugging filed February 13 19 67  
Application for plugging approved February 13 19 67  
Plugging commenced February 13 19 67  
Plugging completed February 13 19 67  
Reason for abandonment of well or producing formation Dry Hole

If a producing well is abandoned, date of last production \_\_\_\_\_ 19\_\_\_\_  
Was permission obtained from the Conservation Division or its agents before plugging was commenced? Yes

Name of Conservation Agent who supervised plugging of this well Gilbert J. Toman, Holyrood, Kansas  
Producing formation \_\_\_\_\_ Depth to top \_\_\_\_\_ Bottom \_\_\_\_\_ Total Depth of Well 3530 Feet  
Show depth and thickness of all water, oil and gas formations.

OIL, GAS OR WATER RECORDS

CASING RECORD

FORMATION	CONTENT	FROM	TO	SIZE	PUT IN	PULLED OUT
		0	247'	8 5/8"	247'	None

Describe in detail the manner in which the well was plugged, indicating where the mud fluid was placed and the method or methods used in introducing it into the hole. If cement or other plugs were used, state the character of same and depth placed, from \_\_\_\_\_ feet to \_\_\_\_\_ feet for each plug set.

Set Plug: 240' / 25 sacks cement & 1/2 sack hulls  
40' / 10 sacks cement & 1/2 sack hulls

15-159-20008-0000  
1-20-67  
02-20-67  
STATE CORPORATION COMMISSION

(If additional description is necessary, use BACK of this sheet)  
Name of Plugging Contractor Hellar Drilling Company, Inc.  
Address 1014 Union Center, Wichita, Kansas 67202

STATE OF Kansas, COUNTY OF Sedgwick, ss.  
D. L. Hellar, Pres. of Hellar Drilling Co. Inc. (employee of owner) or (owner or operator) of the above-described well, being first duly sworn on oath, says: That I have knowledge of the facts, statements, and matters herein contained and the log of the above-described well as filed and that the same are true and correct. So help me God.

(Signature) D. L. Hellar D. L. Hellar, President  
1014 Union Center, Wichita, Kansas 67202  
(Address)

SUBSCRIBED AND SWORN TO before me this 16th day of February, 1967

My commission expires March 25, 1968  
Catherine Darcey Notary Public.

DRILLER'S LOG

COMPANY: Kern Drilling Company, Inc., 337 Union Center, Wichita,  
 CONTRACTOR: Hellar Drilling Company, Inc., Wichita, Kansas Kansas  
 LEASE: #1 Plush  
 LOCATION: C NE NW 34-21S-9W, Rice County, Kansas  
 COMMENCED: February 6, 1967  
 COMPLETED: February 13, 1967  
 CASING: Set 8 5/8" surface casing @ 247'/225 sacks cement

0-100	Sand
100-220	Sand & Shells
220-247	Shale
247-365	Red Bed
365-1150	Red Bed & Shale
1150-1236	Salt Section
1286-1475	Shale
1475-1707	Ft. Riley - cherty lime
1707-1873	Lime & Shale
1873-2521	Shale & Lime
2521-2694	Lime & Shale
2694-2885	Shale & Lime
2885-3007	Douglas Shale
3007-3072	Lime
3072-3198	K. C. Lime
3198-3280	Lime
3280-3471	Lime & Shale
3471-3477½	#1 Core - shale & sand
3477½-3488	#2 Core - shale & sand
3488-3530	Shale & Sandy Shale
3530	Rotary Total Depth

RECEIVED  
 KANSAS MINERAL COMMISSION  
 FEB 20 1967  
 STATE OF KANSAS  
 MINERAL COMMISSION

D & A

STATE OF KANSAS )  
 ) SS  
 COUNTY OF SEDGWICK )

I, D. L. Hellar, do hereby certify that the above and foregoing is a true and correct copy of the log of the #1 Plush, located in C NE/4 NW/4 Sec. 34-21S-9W, Rice County, Kansas, as reflected by the files of the Hellar Drilling Company, Inc.

HELLAR DRILLING COMPANY, INC.

By *D. L. Hellar*  
 President - D. L. Hellar

Subscribed and sworn to before me, a Notary Public, in and for Sedgwick County, Kansas, this 16th day of February, 1967.

*Catherine Darcey*  
 Notary Public - Catherine Darcey

My Commission Expires:  
 March 25, 1968.