


WELL PLUGGING RECORD

Give All Information Completely
 Make Required Affidavit

COUNTY Ness SEC. 28 TWP. 17S RGE. 22 XE/W
 Location as in quarters or footage from lines:
1260' FNL, 330' FWL

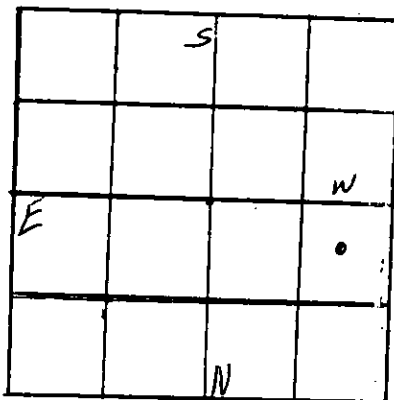

Locate Well
 correctly on above
 Section Platt.

Lease Owner Edward P. Leiker
 Lease Name Pavlu Well No. #1-A
 Office Address Box 17, Munjor Route, Hays, KS 67601
 Character of Well (Completed as Oil, Gas or Dry Hole): dry hole
 Date Well Completed 1/8/84
 Application for plugging filed 1/8/84
 Plugging commenced 1/8/84
 Plugging completed 1/8/84
 Reason for abandonment of well or producing formation dry hole

Was permission obtained from the Conservation Division or it's
 Agent's before plugging was commenced? yes

Name of Conservation Agent who supervised plugging of this well Steve Durrant
 Producing formation _____ Depth to top _____ bottom _____ T.D. 4,300
 Show depth and thickness of all water, oil and gas formations.

OIL, GAS OR WATER RECORDS

Casing Record

Formation	Content	From	To	Size	Put in	Pulled Out.
				8-5/8"	256'	--

Describe in detail the manner in which the well was plugged, indicating where the mud
 fluid was placed and the method or methods used in introducing it into the hold. If cement
 or other plugs were used, state the character of same and depth placed, from _____ feet
 to _____ feet for each plug set.

Mud to 1,560', 50 sx cement
 mud to 720, 50 sx cement
 mud to 270, 40 sx cement
 solid bridge, 1 sx hulls,
 mud to 40, plug, 10 sx cement
 10 sx in rathole
 total cement: 160 sx 60/40 poz
 2%gel, 3%cc

(If additional description is necessary, use BACK of this sheet)

Name of Plugging Contractor DUNNE + GARDNER

STATE OF KANS COUNTY OF Ness, ss.
Edward P. Leiker (employee of owner) or (owner or operator) of the
 above-described well, being first duly sworn on oath, says: That I have knowledge of the
 facts, statements, and matters herein contained and the log of the above-described well as
 filed and that the same are true and correct. So help me God.

(Signature) Edward P. Leiker
HC-32-Box 132-HAYS KS
 (Address) 67601

SUBSCRIBED AND SWORN TO before me this 23 day of January, 19 84

Notary Public - State of Kansas
SUSAN LEIKER
 My Appt. Exp. 1-20-88

My Commission expires: 1-20-88

RECEIVED
 STATE CORPORATION COMMISSION

Notary Public.

FEB 24 1984

CONSERVATION DIVISION
 Wichita, Kansas