


STATE OF KANSAS
STATE CORPORATION COMMISSION
CONSERVATION DIVISION
P. O. BOX 17027
WICHITA, KANSAS 67217

WELL PLUGGING RECORD

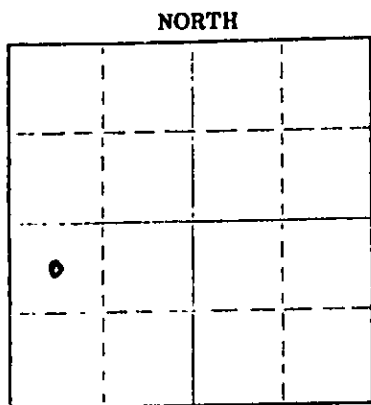

Locate well correctly on above Section Plat

Ness County. Sec. 28 Twp. 17 Rge. (E) 22 (W)
Location as "NE, NW, SW" or footage from lines C SW NW - 660
Lease Owner KANSAS CRUDE INC
Lease Name PAVIL Well No. 1
Office Address MUNJOR RT Box 17 HAYS KANSAS 67601
Character of Well (completed as Oil, Gas or Dry Hole) DRY Hole
Date well completed July 20 1976
Application for plugging filed AUGUST 4 1976
Application for plugging approved August 4 1976
Plugging commenced August 4 1976
Plugging completed August 4 1976
Reason for abandonment of well or producing formation DRY

If a producing well is abandoned, date of last production 10
Was permission obtained from the Conservation Division or its agents before plugging was commenced? Yes

Name of Conservation Agent who supervised plugging of this well Allied Cementing Co
Producing formation Mississippi Depth to top 4274 Bottom 4340 Total Depth of Well 4340
Show depth and thickness of all water, oil and gas formations.

OIL, GAS OR WATER RECORDS				CASING RECORD		
FORMATION	CONTENT	FROM	TO	SIZE	PUT IN	PULLED OUT
Surface	263	0	263	8 5/8	None 263	None
Long string	Production	0	4340	4 1/2	4340	2100
			8-28-76			

Describe in detail the manner in which the well was plugged, indicating where the mud fluid was placed and the method or methods used in introducing it into the hole. If cement or other plugs were used, state the character of same and depth placed, from _____ feet to _____ feet for each plug set.

Cast iron plug set in 4 1/2 pipe at 4200 pulled pipe off at 2100.
Allied cementing co pumped down 8 5/8 casing with 20 gal with 1 hull 70 lb common displaced with 8 lb gal + capped with 50 lb common

(If additional description is necessary, use BACK of this sheet)
Name of Plugging Contractor Allied Cementing Co Russell Kansas
Address Russell Kansas

STATE OF Kansas COUNTY OF Ellis
Operator (employee of owner) or (owner) operator of the above-described

well, being first duly sworn on oath, says: That I have knowledge of the facts, statements, and matters herein contained and the log of the above-described well as filed and that the same are true and correct. So help me God.

(Signature) Edward P. Fisher
Munjoy Rt Hays Kansas 67601
(Address)

Subscribed and Sworn to before me this 17 day of Sept 1976

My commission expires 9-19-77
Notary Public.