

CARD MUST BE TYPED

State of Kansas

CORRECTION
CARD MUST BE SIGNED

NOTICE OF INTENTION TO DRILL

9-17-86

(see rules on reverse side) X

051-24, 429-00-00

Starting Date ... September ... 22, ... 1986 ...
month day year

API Number 15-

* "CORRECTED INTENT" — East

OPERATOR: License # ... 6772 ...
Name ... V. Francis Weigel ...
Address ... P.O. Box 244 ...
City/State/Zip ... Gorham, KS ... 67640 ...
Contact Person ... V. Francis Weigel ...
Phone ... (913) 637-5382 ...

X SE. NE. NE ... Sec. 26 ... Twp. 13 S, Rg. 20 ... X West
4290 ... Ft. from South Line of Section
X 330 ... Ft. from East Line of Section

(Note: Locate well on Section Plat on reverse side)

CONTRACTOR: License # ... 8241 ...
Name ... Emphasis Oil Operations ...
City/State ... P.O. Box 506, Russell, KS ... 67665-0506 ...

X Nearest lease or unit boundary line ... 330 ... feet
County ... Ellis ...
Lease Name ... Herman ... Well # ... J ...

Well Drilled For: Well Class: Type Equipment:
X Oil SWD X Infield X Mud Rotary
Gas Inj Pool Ext Air Rotary
OWWO Expl Wildcat Cable

Ground surface elevation ... 2156 ... feet MSL
Domestic well within 330 feet: — yes X no
Municipal well within one mile: — yes X no

If OWWO: old well info as follows:

Operator ...
Well Name ...
Comp Date ... Old Total Depth ...

Depth to bottom of fresh water ... 100 ...
Depth to bottom of usable water ... 700 ...
Surface pipe by Alternate: 1 X 2

I certify that well will comply with K.S.A. 55-101, et seq., plus eventually plugging hole to KCC specifications.

Date ... 9-15-86 ... Signature of Operator or Agent ... Title ... Agent ...

For KCC Use:

Conductor Pipe Required ... feet; Minimum Surface Pipe Required ... 750 ... feet per Alt. DCP

This Authorization Expires ... 3-15-87 ... Approved By ... 9-15-86 ...


was SW NENE 990 FEL

Must be filed with the K.C.C. five (5) days prior to commencing well
This card void if drilling not started within six (6) months of date received by K.C.C.

Important procedures to follow:

1. Notify District office before setting surface casing.
2. Set surface casing by circulating cement to the top.
3. File completion forms ACO-1 with K.C.C. within 90 days of well completion, following instructions on ACO-1, side 1, and including copies of wireline logs.
4. Notify District office 48 hours prior to old well workover or re-entry.
5. Prior to filing Intent, prepare a proposed plugging plan in case well is D & A, then obtain approval of plan when calling district office prior to setting surface pipe.
6. Submit plugging report (CP-4) to K.C.C. after plugging is completed.
7. Obtain an approved injection docket number before disposing of salt water.
8. Notify K.C.C. within 10 days when injection commences or terminates.
9. If an alternate 2 completion, cement in the production pipe from below any usable water to surface within 120 days of spud date.

A Regular Section of Land
1 Mile = 5,280 Ft.

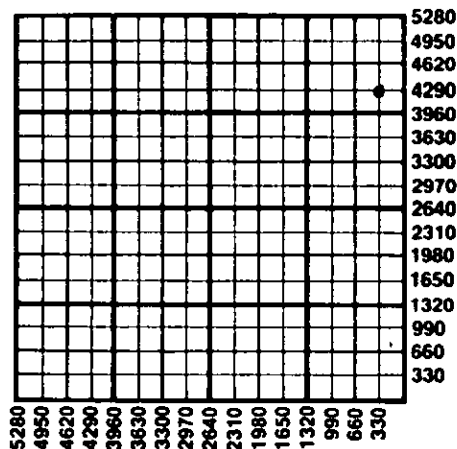

SEP 16 1983

State Corporation Commission of Kansas
Conservation Division
200 Colorado Derby Building
Wichita, Kansas 67202
(316) 263-3238