

NOTICE OF INTENTION TO DRILL

(see rules on reverse side)

Starting Date 10 - 24 - 86  
month day year

API Number 15- 135-23,064-00-00

OPERATOR: License # 6331 & 5146

NW NW SW Sec 2 Twp 17 S, Rg. 21  East  West

Name Taurexco., Inc. & Rains & Williamson Oil Co., Inc.

2310 Ft. from South Line of Section

Address 125 N. Market, Suite 1210

4950 Ft. from East Line of Section

City/State/Zip Wichita, KS 67202

(Note: Locate well on Section Plat on reverse side)

Contact Person Thomas C. Hyde

Nearest lease or unit boundary line 330 feet

Phone 316/262-8339

County Ness

CONTRACTOR: License # 5146

Lease Name Elmore Well # 1-2

Name Rains & Williamson Oil Co., Inc.

Ground surface elevation \_\_\_\_\_ feet MSL

City/State Wichita, KS

Domestic well within 330 feet:  yes  no

Well Drilled For: Well Class: Type Equipment:

Municipal well within one mile:  yes  no

Oil  SWD  Infield  Mud Rotary

Depth to bottom of fresh water 50'

Gas  Inj  Pool Ext.  Air Rotary

Depth to bottom of usable water 800' 700'

OWWO  Expl  Wildcat  Cable

Surface pipe by Alternate:  1  2

If OWWO: old well info as follows:

Surface pipe planned to be set 400'

Operator \_\_\_\_\_

Conductor pipe required \_\_\_\_\_

Well Name \_\_\_\_\_

Projected Total Depth 4200 feet

Comp Date \_\_\_\_\_ Old Total Depth \_\_\_\_\_

Formation Cherokee

I certify that well will comply with K.S.A. 55-101, et seq., plus eventually plugging hole to KCC specifications.

Date 10-15-86 Signature of Operator or Agent Monte K. Mann

Formation \_\_\_\_\_

For KCC Use:

Conductor Pipe Required \_\_\_\_\_ feet; Minimum Surface Pipe Required 200 feet per Alt. 46 (2)


This Authorization Expires 4-15-87 Approved By 10-15-87 R. Pett/KCC

Must be filed with the K.C.C. five (5) days prior to commencing well  
This card void if drilling not started within six (6) months of date received by K.C.C.

**Important procedures to follow:**

1. Notify District office before setting surface casing.
2. Set surface casing by circulating cement to the top.
3. File completion forms ACO-1 with K.C.C. within 90 days of well completion, following instructions on ACO-1, side 1, and including copies of wireline logs.
4. Notify District office 48 hours prior to old well workover or re-entry.
5. Prior to filing Intent, prepare a proposed plugging plan in case well is D & A, then obtain approval of plan when calling district office prior to setting surface pipe.
6. Submit plugging report (CP-4) to K.C.C. after plugging is completed.
7. Obtain an approved injection docket number before disposing of salt water.
8. Notify K.C.C. within 10 days when injection commences or terminates.
9. If an alternate 2 completion, cement in the production pipe from below any usable water to surface within 120 days of spud date.

**A Regular Section of Land  
1 Mile = 5,280 Ft.**

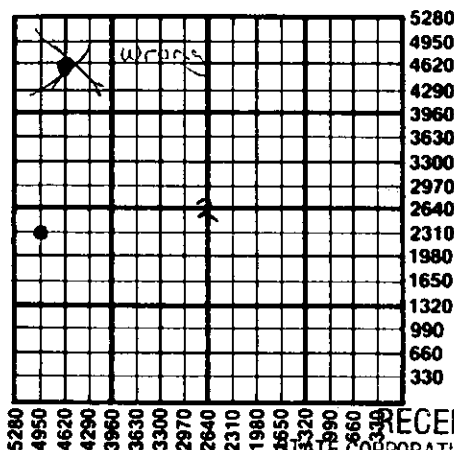

RECEIVED  
STATE CORPORATION COMMISSION

OCT 15 1986  
10-15-1986  
CONSERVATION DIVISION  
Wichita, Kansas

State Corporation Commission of Kansas  
Conservation Division  
200 Colorado Derby Building  
Wichita, Kansas 67202  
(316) 263-3238