

STATE OF KANSAS
STATE CORPORATION COMMISSION

Form CP-4

Give All Information Completely
Make Required Affidavit
Mail or Deliver Report to:
Conservation Division
State Corporation Commission
212 No. Market
Wichita, Kansas 67202

WELL PLUGGING RECORD

Pratt County. Sec. 31 Twp. 26 Rge. 12 (E) (W) X

Location as "NE/CNW/SW" or footage from lines SW SW

Lease Owner Robert L. Austin

Lease Name Honeman Well No. #3

Office Address Stafford, Kansas

Character of Well (completed as Oil, Gas or Dry Hole)

Date well completed 19

Application for plugging filed 19

Application for plugging approved 19


Plugging commenced 12-20-71 19

Plugging completed 1-6-72 19

Reason for abandonment of well or producing formation

If a producing well is abandoned, date of last production 19

Was permission obtained from the Conservation Division or its agents before plugging was commenced?

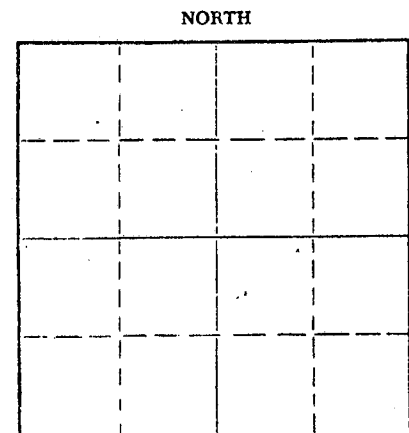

Locate well correctly on above Section Plat

Name of Conservation Agent who supervised plugging of this well G. R. Biberstein

Producing formation Depth to top Bottom Total Depth of Well 4314' Feet

Show depth and thickness of all water, oil and gas formations.

OIL, GAS OR WATER RECORDS

CASING RECORD

FORMATION	CONTENT	FROM	TO	SIZE	PUT IN	PULLED OUT
				5 1/2"	4310'	2468.22'
				8 5/8"	430'	

Describe in detail the manner in which the well was plugged, indicating where the mud fluid was placed and the method or methods used in introducing it into the hole. If cement or other plugs were used, state the character of same and depth placed, from feet to feet for each plug set.

Made bottom hole plug back with sand to 4230'. Mixed and dumped 5 sacks cement thru dump bailer.

Plugged well with 2 sacks hulls - 15 sacks gel and 100 sacks cement to base of cellar.

RECEIVED
STATE CORPORATION COMMISSION
JAN 10 1972
CONSERVATION DIVISION
Wichita, Kansas

(If additional description is necessary, use BACK of this sheet)

Name of Plugging Contractor Southwest Casing Pulling Co.

Address Box 364 Great Bend, Kansas 67530


STATE OF Kansas, COUNTY OF Barton, ss.

Southwest Casing Pulling Co. (employee of owner) or (owner or operator) of the above-described well, being first duly sworn on oath, says: That I have knowledge of the facts, statements, and matters herein contained and the log of the above-described well as filed and that the same are true and correct. So help me God.

(Signature) W. C. Spencer Sec.

Box 364 Great Bend, Kansas (Address)

SUBSCRIBED AND SWORN to before me this 6 day of January, 1972

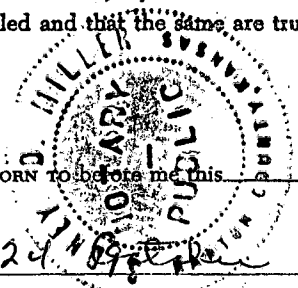

Sidney D. Miller Notary Public.

My commission expires 24 Nov 1972