


STATE OF KANSAS  
STATE CORPORATION COMMISSION

Give All Information Completely  
Make Required Affidavit  
Mail or Deliver Report to:  
Conservation Division  
State Corporation Commission  
800 Bittling Building  
Wichita, Kansas

WELL PLUGGING RECORD

NORTH

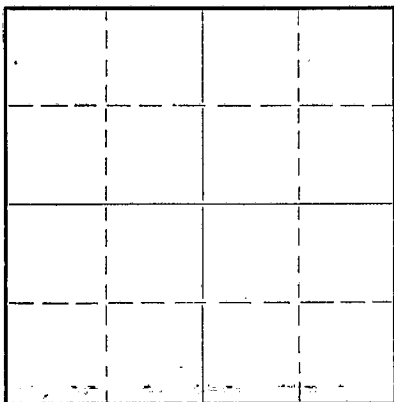

Locate well correctly on above  
Section Plat

Pratt County. Sec. 31 Twp. 26 Rge. 12 (W)  
Location as "NE/CNW 1/4 SW 1/4" or footage from lines SW SE NW  
Lease Owner D. H. Cook  
Lease Name Wm. Honeman Well No. 1  
Office Address 167 W First St. Hoisington, Ks.  
Character of Well (completed as Oil, Gas or Dry Hole) Oil  
Date well completed 6-16-43 19  
Application for plugging filed 10-14-48 19  
Application for plugging approved 10-14-48 19  
Plugging commenced 11-20-48 19  
Plugging completed 11-20-48 19  
Reason for abandonment of well or producing formation Depleted Oil

If a producing well is abandoned, date of last production 19  
Was permission obtained from the Conservation Division or its agents before plugging was commenced? Yes

Name of Conservation Agent who supervised plugging of this well C. D. Stough  
Producing formation Depth to top Bottom Total Depth of Well 431.8 Feet  
Show depth and thickness of all water, oil and gas formations.

OIL, GAS OR WATER RECORDS

CASING RECORD

Formation	Content	From	To	Size	Put In	Pulled Out

Describe in detail the manner in which the well was plugged, indicating where the mud fluid was placed and the method or methods used in introducing it into the hole. If cement or other plugs were used, state the character of same and depth placed, from feet to feet for each plug set.

Surface pipe 8 5/8 - 616 ft. Circulated with cement.  
5 1/2 casing set at 4297'. Plugged back from bottom to 3845' with Lane Wells Plug, chat & cement dumped, 5 sacks cement at 3845'. Shot off and pulled 5 1/2 casing. Filled with mud to 250'. Set bridge and 15 sacks cement at 250'. Mud to 30'. Bridge and 10 sacks cement at the surface.

FEB 17 1949  
STATE CORPORATION COMMISSION  
WICHITA, KANSAS

(If additional description is necessary, use BACK of this sheet)

Correspondence regarding this well should be addressed to D. H. Cook  
Address 167 W. First St.  
Hoisington, Ks.

STATE OF \_\_\_\_\_, COUNTY OF \_\_\_\_\_, ss.  
\_\_\_\_\_(employee of owner) or (owner or operator) of the above-described well,  
being first duly sworn on oath, says: That I have knowledge of the facts, statements, and matters herein contained and the log of the above-described well as filed and that the same are true and correct. So help me God.

(Signature) *D. H. Cook*

(Address)

SUBSCRIBED AND SWORN to before me this 14 day of February, 1949  
*Eda Murand* Notary Public.

My commission expires Nov 24, 1949

PLUGGING  
FILE SEC 31 T 26 R 12 W  
BOOK PAGE 62 LINE 6

**D. H. COOK & CO.**

OIL WELL AND LEASE SERVICING

FEDERAL IDENTIFICATION  
48-0180444

167 WEST 1ST STREET      PHONE 286

KANSAS IDENTIFICATION  
08330-805-133

HOISINGTON, KANSAS

WELL LOG

Operator    D. H. Cook  
Well        Wm. Honeman #1  
Location    SW SE NW Section 31-26S-12W  
              Pratt County, Kansas.

Date Commenced    5-8-43  
Date Completed     6-16-43

Depth	Formation	Depth	Formation
0			
176	Clay and sand	2925	Lime
250	Sand and Shells	2964	Lime and shale
400	Sand and red shale	3030	Shale and lime
621	Red shale	3080	Lime and shale
	Set and cemented 8 5/8" casing	3136	Shale and lime
	@ 616' w/ 200 sacks cement	3195	Lime and shale
985	Shale	3490	Lime
1515	Shale and shells	3552	Sandy lime
1715	Shale, shells and sand	3685	Lime
1720	Shale and shells	3707	Shale and lime
1760	Salt	3802	Lime
1785	Lime and shale	3817	Lime (oil odor)
1950	Shale and shells	4025	Lime
2035	Lime and shale	4080	Lime and shale
2081	Shale and Lime	4105	Lime, shale and chat
2190	Lime salt streaks	4125	Chat
2270	Shale and lime	4135	Chat and shale
2297	Lime and shale	4160	Chat
2340	Lime, shale streaks	4179	Chat and shale
2370	Lime and shale	4200	Shale and sand
2388	Shale and lime	4208	Chat and shale
2410	Lime	4240	Sand
2470	Lime and shale	4257	Shale and sand
2525	Shale and shells	4290	Lime and chert
2570	Broken shale	4298	Lime
2665	Shale and shells		Set and cemented 5 1/2" casing
2880	Shale and lime		@ 4297' w/ 650 sacks cement
		4318	Lime T.D.

**PLUGGING**  
FILE REC-31726212W  
BOOK PAGE 62-116

STATE OF KANSAS  
OCT 14 1948