


15-135-21631-00-00

STATE OF KANSAS
STATE CORPORATION COMMISSION

Form CP-4

Give All Information Completely
Make Required Affidavit
Mail or Deliver Report to:
Conservation Division
State Corporation Commission
P. O. Box 17027
Wichita, Kansas 67217
NORTH

WELL PLUGGING RECORD

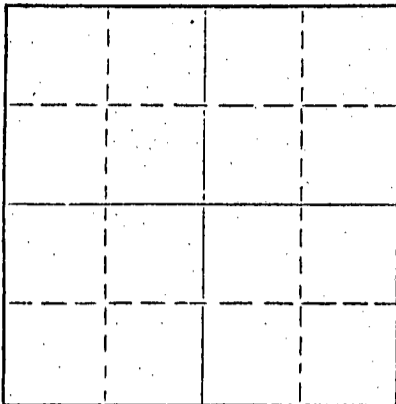

Locate well correctly on above Section Plat

Ness County, Sec. 13 Twp. 17S Rge. (E) 26W (W)
Location as "NE/CNW%SW%" or footage from lines C S/2 SE SW
Lease Owner Chief Drilling Co., Inc.
Lease Name Quenzer "A" Well No. #1
Office Address 905 Century Plaza, Wichita, Kansas 67202
Character of Well (completed as Oil, Gas or Dry Hole) Dry hole
Date well completed Oct. 11, 1979 19
Application for plugging filed Oct. 11, 1979 19
Application for plugging approved Oct. 11, 1979 19
Plugging commenced Oct. 11, 1979 19
Plugging completed Oct. 11, 1979 19
Reason for abandonment of well or producing formation dry hole

If a producing well is abandoned, date of last production 19
Was permission obtained from the Conservation Division or its agents before plugging was commenced? Yes

Name of Conservation Agent who supervised plugging of this well Marvin Schmidt
Producing formation _____ Depth to top _____ Bottom _____ Total Depth of Well 4442' Feet
Show depth and thickness of all water, oil and gas formations.

OIL, GAS OR WATER RECORDS

CASING RECORD

FORMATION	CONTENT	FROM	TO	SIZE	PUT IN	PULLED OUT
				8 5/8"	312'	-0-

Describe in detail the manner in which the well was plugged, indicating where the mud fluid was placed and the method or methods used in introducing it into the hole. If cement or other plugs were used, state the character of same and depth placed, from _____ feet to _____ feet for each plug set.

Plugged through drill pipe @ 1060' w/70 sx. cement
Plugged through drill pipe @ 310' w/20 sx. cement
Plugged through drill pipe @ 40' w/10sx. cement
5 sx. cement in rathole

RECEIVED
STATE CORPORATION COMMISSION
OCT 18 1979
CONSERVATION DIVISION
Wichita, Kansas

(If additional description is necessary, use BACK of this sheet)

Name of Plugging Contractor Chief Drilling Co., Inc.
Address 905 Century Plaza, Wichita, Kansas 67202

STATE OF KANSAS, COUNTY OF SEDGWICK, ss.
Bill G. Lahar (employen of owner) or (owner or operator) of the above-described well, being first duly sworn on oath, says: That I have knowledge of the facts, statements, and matters herein contained and the log of the above-described well as filed and that the same are true and correct. So help me God.

(Signature) Bill G. Lahar
905 Century Plaza, Wichita, Ks. 67202
(Address)

SUBSCRIBED AND SWORN TO before me this 17th day of October, 19 79

MARILYN SINARD
STATE NOTARY PUBLIC
SEDGWICK COUNTY, KANSAS
MY APPT. EXP. 4-30-83

Marilyn Sinard
Notary Public.

My commission expires

WELL LOG

CHIEF DRILLING CO., INC.
 905 Century Plaza
 Wichita, Kansas 67202

#1 QUENZER "A"
 C S/2 SE SW
 Sec. 13-17S-26W
 Ness County, Kansas

CONTRACTOR: Warrior Drilling, Inc.
 CASING RECORD: 8 5/8" @ 312' w/180 sx.

COMMENCED: Oct. 3, 1979
 COMPLETED: Oct. 11, 1979

<u>FORMATION</u>	<u>FROM</u>	<u>TO</u>	<u>ELEVATIONS</u>
Surface Sand & Clay	0	310	2488 Gr.
Sand & Shale	310	1230	2490 D.F.
Shale	1230	2513	2493 K.B.
Shale & Lime	2513	3384	
Lime & Shale	3384	3793	
Shale & Lime	3793	4120	
Lime	4120	4442	
RTD	4442		

D & A

RECEIVED
 STATE CORPORATION COMMISSION
 OCT 18 1979
 CONSERVATION DIVISION
 Wichita, Kansas

STATE OF KANSAS, COUNTY OF SEDGWICK) ss:

I hereby certify that the above is a true and correct copy of the Driller's Log of the well drilled in the C S/2 SE SW Sec. 13-17S-26W, Ness County, Kansas, to the best of my knowledge and belief.

CHIEF DRILLING CO., INC.

Bill G. Lahar
 Bill G. Lahar, Manager of Exploration

Subscribed and sworn to before me this 17th day of October, 1979

MARILYN SINARD
 STATE NOTARY PUBLIC
 SEDGWICK COUNTY, KANSAS
 MY APPT. EXP. 4-30-83

Marilyn Sinard
 Marilyn Sinard Notary Public