

15-135-00324-00-00

STATE OF KANSAS
STATE CORPORATION COMMISSION

WELL PLUGGING RECORD

Give All Information Completely
Make Required Affidavit
Mail or Deliver Report to:
Conservation Division
State Corporation Commission
211 No. Broadway
Wichita, Kansas

NESS

County, Sec. 13 Twp. 17S Rge. (E) 26 (W)

Location as "NE/CNW&SW¼" or footage from lines CENTER SE/4 SW/4

Lease Owner TWIN DRILLING, INC.

Lease Name QUENZER Well No. 1

Office Address 1732 WICHITA PLAZA, WICHITA, KANSAS 67202

Character of Well (completed as Oil, Gas or Dry Hole) DRY HOLE

Date well completed 9 APRIL 19 64

Application for plugging filed 9 APRIL 19 64

Application for plugging approved 9 APRIL 19 64


Plugging commenced 9 APRIL 19 64

Plugging completed 9 APRIL 19 64

Reason for abandonment of well or producing formation DRY HOLE

If a producing well is abandoned, date of last production NONE 19

Was permission obtained from the Conservation Division or its agents before plugging was commenced? YES

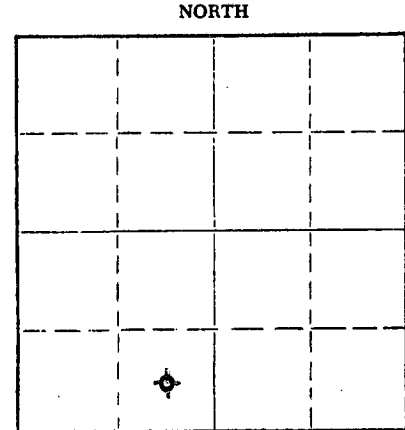

Locate well correctly on above Section Plat

Name of Conservation Agent who supervised plugging of this well ELDON PETTY

Producing formation NONE Depth to top Bottom Total Depth of Well 4480 Feet

Show depth and thickness of all water, oil and gas formations.

OIL, GAS OR WATER RECORDS

CASING RECORD

FORMATION	CONTENT	FROM	TO	SIZE	PUT IN	PULLED OUT
<u>SURFACE HOLE</u>	<u>WATER</u>	<u>SURFACE</u>	<u>240' RB</u>	<u>8 5/8" OD</u>	<u>233.80'</u>	<u>LEFT IN</u>
<u>(SEE ATTACHED LOG)</u>						

Describe in detail the manner in which the well was plugged, indicating where the mud fluid was placed and the method or methods used in introducing it into the hole. If cement or other plugs were used, state the character of same and depth placed, from feet to feet for each plug set.

FILLED HOLE TO 750' WITH DRILLING MUD, SET PLUG AND CEMENTED WITH 20 SACKS CEMENT, MIXED AND PUMPED THROUGH DRILL PIPE, FILLED HOLE WITH DRILLING MUD TO 200' , SET PLUG AND CEMENTED WITH 20 SACKS CEMENT, MIXED AND PUMPED THROUGH DRILL PIPE, FILLED HOLE WITH DRILLING MUD TO 35', SET PLUG AND CEMENTED TO SURFACE WITH 10 SACKS CEMENT, MIXED AND PUMPED THROUGH DRILL PIPE.

RECEIVED
STATE CORPORATION COMMISSION

APR 22 1964

CONSERVATION DIVISION
Wichita, Kansas

(If additional description is necessary, use BACK of this sheet)

Name of Plugging Contractor REX & MORRIS DRILLING COMPANY
Address P. O. BOX 334, EL DORADO, KANSAS

STATE OF KANSAS, COUNTY OF BUTLER, ss.
A. H. FISHER (employee of owner) or (owner or operator) of the above-described

well, being first duly sworn on oath, says: That I have knowledge of the facts, statements, and matters herein contained and the log of the above-described well as filed and that the same are true and correct. So help me God.

(Signature) A. H. Fisher

P. O. BOX 334, EL DORADO, KANSAS
(Address)

SUBSCRIBED AND SWORN TO before me this 20TH day of APRIL, 19 64

My commission expires 8 AUGUST 1966

Elizabeth Deschner
ELIZABETH DESCHNER

Notary Public.



15-135-00324-00-00

Elevation 2494 RB
2489 DF

QUENZER # 1

Twin Drilling Company, et al.

Total Depth: 4480
Contractor: Rex & Morris
Commenced: 3-31-64
Completed: 4-9-64
Initial Prod.: D. & A.

Location C SE SW
Section 13-17S-26W
Ness County, Kansas

Casing Record:
8 5/8 @ 240' w/200 sacks

<u>FORMATION</u>	<u>DEPTH</u>
Surface Hole	240
Shale	1205
Anhydrite	1235
Shale	2230
Lime and Shale	2800
Lime	3275
Lime and Shale	3505
Lime	4348
Lime and Shale	4433
Lime (Miss.)	4480

TD

RECEIVED
STATE CORPORATION COMMISSION

APR 22 1964

CONSERVATION DIVISION
Wichita, Kansas

I hereby acknowledge the foregoing statements are true and correct to the best of my knowledge and belief.

Rex & Morris Drilling Company

By Paul D. Koontz
Paul D. Koontz, Geologist

STATE OF KANSAS
COUNTY OF BUTLER, SS.

Subscribed and sworn to before me this 17th day of April, 1964.

Elizabeth Deschner
Elizabeth Deschner, Notary Public

My commission expires: August 8, 1966

