


STATE OF KANSAS
STATE CORPORATION COMMISSION

Form CP-4

Give All Information Completely
Make Required Affidavit
Mail or Deliver Report to:
Conservation Division
State Corporation Commission
P. O. Box 17027
Wichita, Kansas 67217
NORTH

WELL PLUGGING RECORD

Ness County. Sec. 14 Twp. 17S Rge. ~~X~~ 26W (W)
Location as "NE/CNW/SW" or footage from lines. C SW NW
Lease Owner Pickrell Drilling Company
Lease Name Dumler "U" Well No. 3
Office Address 705 Fourth National Bank Bldg., Wichita, Kansas
Character of Well (completed as Oil, Gas or Dry Hole) Dry Hole
Date well completed June 23 19 72
Application for plugging filed June 23 19 72
Application for plugging approved June 23 19 72
Plugging commenced June 23 19 72
Plugging completed June 23 19 72
Reason for abandonment of well or producing formation Dry Hole

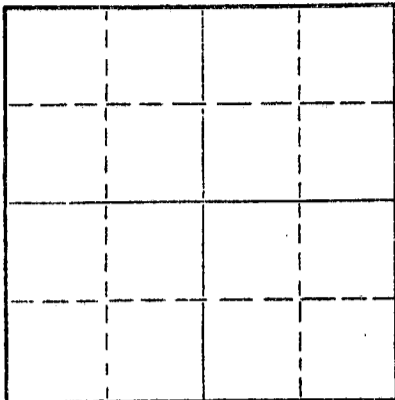

Locate well correctly on above
Section Plat

If a producing well is abandoned, date of last production 19
Was permission obtained from the Conservation Division or its agents before plugging was commenced? Yes

Name of Conservation Agent who supervised plugging of this well Leo F. Massey
Producing formation _____ Depth to top _____ Bottom _____ Total Depth of Well 4519' Feet
Show depth and thickness of all water, oil and gas formations.

OIL, GAS OR WATER RECORDS

CASING RECORD

FORMATION	CONTENT	FROM	TO	SIZE	PUT IN	PULLED OUT
				8-5/8"	270'	None

Describe in detail the manner in which the well was plugged, indicating where the mud fluid was placed and the method or methods used in introducing it into the hole. If cement or other plugs were used, state the character of same and depth placed, from _____ feet to _____ feet for each plug set.

Bottom Plug @ 720' w/70 sacks, Middle Plug @ 240' w/20 sacks,
Top Plug @ 40' w/10 sacks.

RECEIVED
STATE CORPORATION COMMISSION

JUN 30 1972

CONSERVATION DIVISION
Wichita, Kansas

Name of Plugging Contractor Pickrell Drilling Company
Address 705 Fourth National Bank Building, Wichita, Kansas 67202

STATE OF Kansas, COUNTY OF Sedgwick, ss.
C. W. Sebitts (employee of owner) or (owner or operator) of the above-described well, being first duly sworn on oath, says: That I have knowledge of the facts, statements and matters herein contained and the log of the above-described well as filed and that the same are true and correct. So help me God.

(Signature) C. W. Sebitts
705 Fourth National Bank Bldg., Wichita, Kansas
(Address)

Subscribed and sworn to before me this 28th day of June, 1972
January 19, 1973



Esther Lamone
Notary Public.

ROTARY DRILLING LOG

R

COMPANY: Pickrell Drilling Company
 705 Fourth National Bank Bldg.
 Wichita, Kansas 67202

Rotary Drilling Commenced 6/12/72
 Rotary Drilling Completed 6/23/72

LOCATION: Dumler "U" No. 3, C SW NW Sec. 14-17S-26W,
 Ness County, Kansas

CONTRACTOR: **PICKRELL DRILLING COMPANY**
 Wichita, Kansas

CASING RECORD: Run 7 Jts. 8-5/8" surface casing set @ 270'. Cemented w/150
 sacks. Completed 5:30 P.M. Circulated.

No oil string run. D & A, Plugged down 3:15 P.M. June 23, 1972

LOG

(Figures indicate bottom of formation — measurements from top of rotary bushing.)


130	Clay - Post Rock	C.F.S.
155	Sand - Shale	4240
273	Shale & Shells	4270
920	Shale	4407
1420	Shale & Red Beds	4490
1615	Sand	4498
1898	Shale	4503
1935	Anhydrite	4519
2670	Shale	
2820	Shale & Lime	
3220	Lime & Shale	
3515	Shale - Lime	
3655	Lime & Shale	
3910	Shale - Lime	Slope Tests
4145	Lime - Shale	2000
4508	Lime	2500
4519	Mississippi, RTD	3000
		3500
		4000
		4500

RECEIVED
 STATE CORPORATION COMMISSION
 JUN 30 1972
 CONSERVATION DIVISION
 Wichita, Kansas

The undersigned, C. W. Sebitts, Attorney-in-Fact for PICKRELL DRILLING COMPANY, hereby certifies in behalf of said Company, that the above is a true and correct log of the formation encountered in drilling the above well as reflected by the Daily Drilling Reports.

PICKRELL DRILLING COMPANY
 By [Signature]
 C. W. Sebitts Attorney-in-Fact

STATE OF KANSAS }
 COUNTY OF SEDGWICK } ss.:

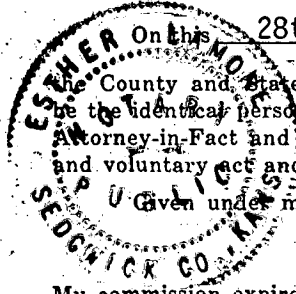

On this 28th day of June, 19 72, before me the undersigned, a Notary Public, in and for County and State aforesaid, personally appeared C. W. Sebitts, to me known to be the identical person who subscribed the name of PICKRELL DRILLING COMPANY to the foregoing instrument as its Attorney-in-Fact and acknowledged to me that he executed the same as his free and voluntary act and deed, and as the free and voluntary act and deed of such company, for the uses and purposes therein set forth.

Given under my hand and seal of office the day and year last above written.

My commission expires: January 19, 1973

Esther Lamone
 Notary Public