

WELL PLUGGING RECORD

Give All Information Completely  
Make Required Affidavit  
Mail or Deliver Report to:  
Conservation Division  
State Corporation Commission  
212 North Market, Insurance Bldg.  
Wichita, Kansas

Ness County, Sec. 14 Twp. 17S Rge. 26 (W)

Location as "NE/CNW/SW" or footage from lines C SE/4 SW/4

Lease Owner Twin Drilling, Inc.

Lease Name Daniels Well No. \_\_\_\_\_

Office Address 1005 Central Building, Wichita, Kansas

Character of Well (completed as Oil, Gas or Dry Hole) Dry Hole

Date well completed 3-31 19 61

Application for plugging filed 4-3 19 61

Application for plugging approved 4-5 19 61

Plugging commenced 4-2 19 61


Plugging completed 4-2 19 61

Reason for abandonment of well or producing formation \_\_\_\_\_

Dry Hole

If a producing well is abandoned, date of last production \_\_\_\_\_ 19 \_\_\_\_\_

Was permission obtained from the Conservation Division or its agents before plugging was commenced? Yes

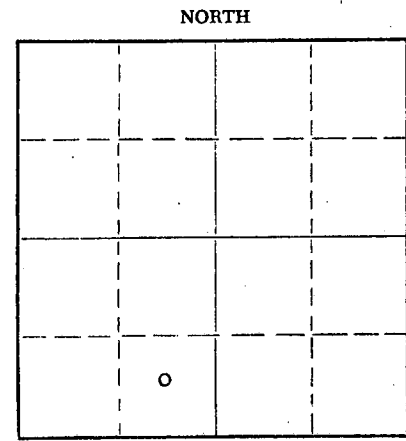

Locate well correctly on above Section Plat

Name of Conservation Agent who supervised plugging of this well Gilbert Leiker, 805 Main, Victoris, Kansas

Producing formation \_\_\_\_\_ Depth to top \_\_\_\_\_ Bottom \_\_\_\_\_ Total Depth of Well 4525 Feet

Show depth and thickness of all water, oil and gas formations.

OIL, GAS OR WATER RECORDS

CASING RECORD

FORMATION	CONTENT	FROM	TO	SIZE	PUT IN	PULLED OUT
				8 5/8"	204.57'	-
				4 1/2"	4551.17'	2328.81'

Describe in detail the manner in which the well was plugged, indicating where the mud fluid was placed and the method or methods used in introducing it into the hole. If cement or other plugs were used, state the character of same and depth placed, from \_\_\_\_\_ feet to \_\_\_\_\_ feet for each plug set.

Fill hole with heavy mud to 200' of top.

Set bridge and cement with 20 sacks mixed cement

Fill hole on up to 40' of Surface

Set bridge and cement with 10 sacks cement.

RECEIVED  
STATE CORPORATION COMMISSION

APR 13 1961

CONSERVATION DIVISION  
Wichita, Kansas

(If additional description is necessary, use BACK of this sheet)

Name of Plugging Contractor Twin Drilling, Inc.

Address 1005 Central Building Wichita, Kansas

STATE OF Kansas, COUNTY OF Sedgwick, ss.

C. R. Dunne (employee of owner) or (owner or operator) of the above-described well, being first duly sworn on oath, says: That I have knowledge of the facts, statements, and matters herein contained and the log of the above-described well as filed and that the same are true and correct. So help me God.

(Signature) [Signature]

1005 Central Building, Wichita, Kansas  
(Address)

SUBSCRIBED AND SWORN TO before me this 12 day of April, 19 61

My commission expires September 9, 1961

[Signature]  
Notary Public.



WELL LOG

Operator: Twin Drilling, Inc.  
1005 Central Building  
Wichita, Kansas

Well: Daniels #1  
Location: C SE/4 SW/4  
Section 14-17S-26W  
Ness County, Kansas

Contractor: Same

Elevation: 2521 GR

Casing: 8 5/8" - 204.57' W/125 Sax  
4 1/2" - 4551.17' W/125 Sax

Commenced: 2-20-61  
Completed: 3- 6-61

Soil	115
Shale & lime shells	210
Shale	488
Sand & shale	1029
Shale & lime shells	1088
Red bed shale & shells	1230
Anhydrite	1270
Shale & shells	1865
Lime & shale	2320
Shale	2428
Lime & shale	2610
Lime w/shale breaks	2734
Broken lime & shale	2867
Lime	2915
Lime & shale	3780
Lime	4160
Broken lime	4202
Lime	4250
Lime w/shale streaks	4286
Lime & shale	4401
Lime	4447
Lime & sand	4458
Lime	4476
Lime & chert	4500
Chert & shale	4525
Rotary T.D.	4525'

Tops:

Heebner	3799'
Toronto	3819'
Lansing	3840'
Base Kansas City	4162'
Cherokee shale	4353'
Cherokee sand	4437'
Mississippian	4466'

RECORDED  
STATE DEPT. OF REVENUE

APR 1961

CONSTRUCTION DIVISION  
WICHITA, KANSAS

STATE OF KANSAS )  
                          ) ss.  
COUNTY OF SEDGWICK )

The undersigned, TWIN DRILLING, INC., hereby certifies that the above log is a true and correct log of the formations encountered in drilling the above well as reflected by the Daily Drilling Report.

TWIN DRILLING, INC.

By: Alma Day

Subscribed and sworn to before me  
this 17th day of March, 1961.

James S. Pich  
Notary Public

My commission expires  
September 29, 1964.