


STATE OF KANSAS
STATE CORPORATION COMMISSION

Give All Information Completely
Make Required Affidavit
Mail or Deliver Report to:
Conservation Division
State Corporation Commission
211 No. Broadway
Wichita, Kansas

15-135-00543-00-00

WELL PLUGGING RECORD

NORTH

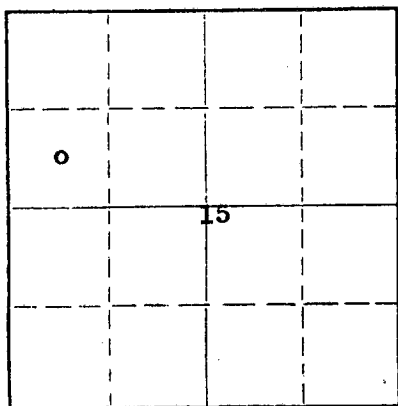

Locate well correctly on above
Section Plat

Ness County. Sec. 15 Twp. 17S Rge. 26W (E) (W)

Location as "NE/CNW/SW" or footage from lines c SW NW

Lease Owner Hellar Drilling Company, Inc.

Lease Name Nuss Well No. 1

Office Address 1014 Union Center, Wichita, Kansas

Character of Well (completed as Oil, Gas or Dry Hole) Dry Hole

Date well completed October 1 19 62

Application for plugging filed October 1 19 62

Application for plugging approved October 1 19 62

Plugging commenced October 1 19 62

Plugging completed October 1 19 62

Reason for abandonment of well or producing formation Dry Hole

If a producing well is abandoned, date of last production 19

Was permission obtained from the Conservation Division or its agents before plugging was commenced? Yes

Name of Conservation Agent who supervised plugging of this well Eldon Petty, Box 326, Hays, Kansas

Producing formation Depth to top Bottom Total Depth of Well Feet

Show depth and thickness of all water, oil and gas formations.

OIL, GAS OR WATER RECORDS

CASING RECORD

FORMATION	CONTENT	FROM	TO	SIZE	PUT IN	PULLED OUT
		0	286'	8 5/8	286'	None

Describe in detail the manner in which the well was plugged, indicating where the mud fluid was placed and the method or methods used in introducing it into the hole. If cement or other plugs were used, state the character of same and depth placed, from feet to feet for each plug set.

Set Plug @ 500' 15 sacks cement & 1/4 sack hulls

Plug @ 27' 10 sacks cement & 1/4 sack hulls

Plug @ 20' 10 sacks cement

RECEIVED

STATE CORPORATION COMMISSION

OCT 29 1962

CONSERVATION DIVISION

Wichita, Kansas

(If additional description is necessary, use BACK of this sheet)

Name of Plugging Contractor Hellar Drilling Company, Inc.

Address 1014 Union Center, Wichita 2, Kansas

STATE OF Kansas COUNTY OF Sedgwick, ss.

D. L. Hellar, President of Hellar Drlg. Co. (employee of owner) or (owner or operator) of the above-described well, being first duly sworn on oath, says: That I have knowledge of the facts, statements, and matters herein contained and the log of the above-described well as filed and that the same are true and correct. So help me God.

(Signature)

D. L. Hellar, President

1014 Union Center, Wichita 2, Kansas

(Address)

SUBSCRIBED AND SWORN TO before me this 25th day of October, 19 62

Catherine Darcey

Notary Public.

My commission expires

March 25, 1964.

DRILLER'S LOG

OWNER: Hellar Drilling Company, Inc.
 CONTRACTOR: Hellar Drilling Company, Inc.
 LEASE: #1 Nuss
 LOCATION: c SW NW Section 15-17S-26W
 Ness County, Kansas
 COMMENCED: September 5, 1962
 COMPLETED: October 1, 1962
 CASING: Set 8 5/8" surface casing @ 286'
 /215 sacks cement.

0- 286	Shale
286-1374	Shale & Shells
1374-1381	Blaine
1381-1902	Shale & Shells
1902-1966	Shell & Lime
1966-1995	Anhydrite
1995-2235	Shale & Shells
2235-2469	Shale, Shells-Salt-Shale
2469-2663	Ft. Riley section
2663-2816	Lime & Shale
2816-2886	Ft. Riley section
2886-3185	Lime & Shale
3185-3257	Shale & Lime
3257-3381	Lime & Shale
3381-3725	Shale & Lime
3725-3778	Lime
3778-3833	Chalk-Lime-Shale
3833-3913	Lime
3913-3963	Lime
3963-4023	Lime-Lansing-K.C.
4023-4072	Lansing-K.C.
4072-4195	Lime
4195-4249	Lime-Shale
4249-4350	Lime
4350-4380	Shale
4380-4430	Lime-Shale
4430-4441	Lime-Shale-Streaks chert
4441-4501	Lime
4501-4510	Conglomerate
4510-4554	Mississippi
4554	Rotary Total Depth
	D & A

OIL & GAS COMMISSION

OCT 2 1962

CONSERVATION DIVISION
Wichita, Kansas

STATE OF KANSAS)
) SS
 COUNTY OF SEDGWICK)

I, D. L. Hellar, do hereby certify that the above and foregoing is a true and correct copy of the log of the #1 Nuss, located in the c SW NW of Section 15-17S-26W, Ness County, Kansas, as reflected by the files of the Hellar Drilling Company, Inc.

HELLAR DRILLING COMPANY, INC.

By: D. L. Hellar
 D. L. Hellar, President

Subscribed and sworn to before me, a Notary Public, in and for Sedgwick County, Kansas, this 25th day of October, 1962.

Catherine Darcey
 Notary Public - Catherine Darcey

My Commission Expires:
 March 25, 1964.