

STATE OF KANSAS
STATE CORPORATION COMMISSION

RECEIVED

15-135-21521-00-00

WELL PLUGGING RECORD

Give All Information Completely


Make Required Affidavit

Mail or Deliver Report to
Conservation Division

State Corporation Comm.

245 North Water

Wichita, KS 67202

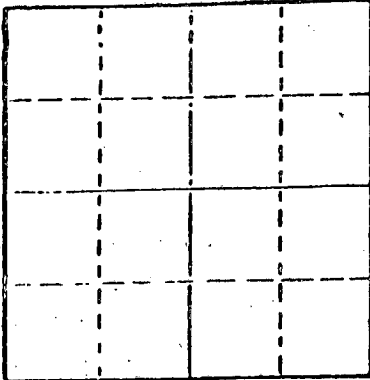Locate well correctly on above
Section PlotPALOMINO
PETROLEUM

Ness

County. Sec. 15 Twp. 17S Rge. 26W E/W

Location as "NE/CNW1SW1" or footage from lines

C N/2 N/2

Lease Owner Palomino Petroleum

Lease Name Klement Well No. #1

Office Address 500 Insurance Building, Wichita, Kansas 67202

Character of Well (Completed as Oil, Gas or Dry Hole)
dry hole

Date Well completed November 1, 1978 19

Application for plugging filed November 1, 1978 19

Application for plugging approved November 1, 1978 19

Plugging commenced November 1, 1978 19

Plugging completed November 1, 1978 19

Reason for abandonment of well or producing formation

dry hole

If a producing well is abandoned, date of last production
19Was permission obtained from the Conservation Division or
its agents before plugging was commenced? yes

Name of Conservation Agent who supervised plugging of this well Leo Massey

Producing formation Depth to top Bottom Total Depth of Well 4525'

Show depth and thickness of all water, oil and gas formations.

OIL, GAS OR WATER RECORDS

CASING RECORD

FORMATION	CONTENT	FROM	TO	SIZE	PUT IN	PULLED OUT

Describe in detail the manner in which the well was plugged, indicating where the mud fluid was placed and the method or methods used in introducing it into the hold. If cement or other plugs were used, state the character of same and depth placed; from feet to feet for each plug set.

Hole plugged with 50-50 pozmix, 6% gel, as follows:
70 sacks @ 720', 20 sacks @ 240', hulls and 10 sacks @ 40'. Plugging
completed at 4:30 a.m., November 1, 1978.RECEIVED
STATE CORPORATION COMMISSION

NOV 13 1978

CONSERVATION DIVISION
Wichita, Kansas

(If additional description is necessary, use BACK of this sheet)

Name of Plugging Contractor Strata Drilling Company

STATE OF KANSAS

COUNTY OF BARTON

, ss.

Kenneth J. Link

(employee of owner) or (owner or operator)

of the above-described well, being first duly sworn on oath, says: That I have knowledge of the facts, statements, and matters herein contained and the log of the above-described well as filed and that the same are true and correct. So help me God.

(Signature)

Kenneth J. Link

President

P. O. Box 355, Great Bend, Kansas 67530

(Address)


SUBSCRIBED AND SWORN TO before me this 6th day of November, 1978.

Loneita Barry

Loneita Barry

Notary Public.

My commission expires 3-28-80.

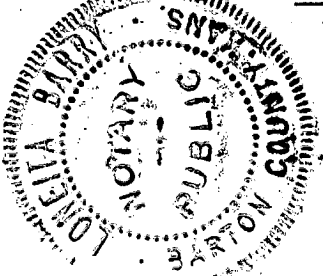

D R I L L E R S L O G

#1 Klement

CASING RECORD:
7 jts. new 20#
8-5/8" surface
casing

COMPANY: Palomino Petroleum
CONTRACTOR: Strata Drilling Company
COMMENCED: October 27, 1978
COMPLETED: November 1, 1978

DESCRIPTION: C N/2 N/2
Section 15-17S-26W
Ness County, Kansas
ELEVATION: 2572' KB

TOTAL ROTARY
DEPTH: 4525'

D & A

<u>FORMATION</u>	<u>FROM</u>	<u>TO</u>	<u>REMARKS</u>
Post rock and shale	0	300	Ran 281' new 20# 8-5/8" surface casing, set and cemented @ 286' with 185 sacks common cement, 2% gel, 3% C.C. Cement circulated. Plug down at 8:50 p.m., October 27, 1978.
Shale, sand, shale	300	1932	
Anhydrite	1932	1965	
Shale	1965	2565	Ran one drill stem test. Hole plugged with 50-50 pozmix, 6% gel, as follows: 70 sacks at 720', 20 sacks at 240', hulls and 10 sacks at 40'. Plugging completed at 4:30 a.m., November 1, 1978.
Lime and shale	2565	4020	
Lime	4020	4140	
Lime and shale	4140	4348	
Lime	4348	4525	

STATE OF KANSAS)
)ss
COUNTY OF BARTON)

I certify that this is a true and correct copy of the above log to the best of my knowledge.

STRATA DRILLING COMPANY

Kenneth J. Link
Kenneth J. Link, President

Sworn to and subscribed before me this 6th day of November, 1978.

My appointment expires 3-28-80.

Loneita Barry
Loneita Barry, Notary Public

RECEIVED
STATE CORPORATION COMMISSION

NOV 13 1978

CONSERVATION DIVISION
Wichita, Kansas

