

This form shall be filed in duplicate with the Kansas Corporation Commission, 200 Colorado Derby Building, Wichita, Kansas 67202, within ten days after the completion of the well, regardless of how the well was completed.

Attach separate letter of request if the information is to be held confidential. If confidential, only file one copy. Information on side one will be of public record and side two will then be held confidential.

Circle one: Oil, Gas, Dry SWD, OWWO, Injection. Type and complete ALL sections. Applications must be filed for dual completion, commingling, SWD and injection, T.A.

Attach wireline logs (i.e. electrical log, sonic log, gamma ray neutron log, etc.). KCC # (316) 263-3238. (Rules 82-2-105 & 82-2-125)

OPERATOR Pendleton Land and Exploration, Inc.

API NO. 15-135-22,175-0000

ADDRESS 23 Inverness Way East Englewood, CO 80112

COUNTY Ness

FIELD wildcat

\*\*CONTACT PERSON Lee Brian VanRamshorst PHONE 303/773-1776

PROD. FORMATION - - - - -

LEASE Fitzgerald

PURCHASER - - - - -

WELL NO. 1 (one)

ADDRESS - - - - -

WELL LOCATION 520' FNL & 910' FWL of Sec

DRILLING Silverado Drilling, Inc.

520 Ft. from N Line and

CONTRACTOR

910 Ft. from W Line of

ADDRESS 435 Page Court - 220 W. Douglas

the NW 1/4 SEC. 20 TWP. 18S RGE. 24W

Wichita, KS 67202

WELL PLAT

PLUGGING same

STATE CORPORATION COMMISSION

CONTRACTOR


ADDRESS

FEB 18 1982

CONSERVATION DIVISION

Wichita, Kansas

TOTAL DEPTH 4400' PBTD

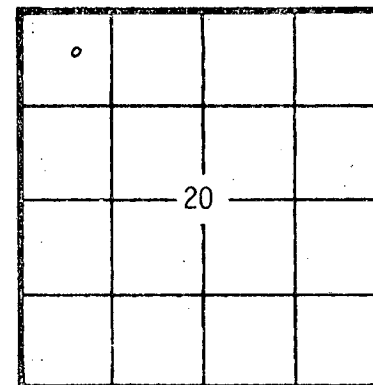

KCC KGS (Office Use)

SPUD DATE 11/28/81 DATE COMPLETED 12/11/81

ELEV: GR 2283' DF KB 2292'

DRILLED WITH (CABLE) (ROTARY) (AIR) TOOLS

Amount of surface pipe set and cemented. 660' DV Tool Used? no

AFFIDAVIT

STATE OF Colorado, COUNTY OF Arapahoe SS, I,

Lee Brian VanRamshorst OF LAWFUL AGE, BEING FIRST DULY SWORN UPON HIS OATH,

DEPOSES THAT HE IS Manager of Operations (FOR)(OF) Pendleton Land and Exploration, Inc.

OPERATOR OF THE Fitzgerald LEASE, AND IS DULY AUTHORIZED TO MAKE

THIS AFFIDAVIT FOR AND ON THE BEHALF OF SAID OPERATOR, THAT WELL NO. 1 ON

SAID LEASE HAS BEEN COMPLETED AS OF THE 11th DAY OF December, 1981, AND THAT

ALL INFORMATION ENTERED HEREIN WITH RESPECT TO SAID WELL IS TRUE AND CORRECT.

FURTHER AFFIANT SAITH NOT.

(S) [Signature]

SUBSCRIBED AND SWORN BEFORE ME THIS 9th DAY OF February, 19 82.

[Signature]

NOTARY PUBLIC

MY COMMISSION EXPIRES: September 21, 1985

Emily Ann Downs 23 Inverness Way East, Englewood, CO 80112

\*\*The person who can be reached by phone regarding any questions concerning this information. Within 45 days of completion, a witnessed initial test by the Commission is required if the well produces more than 25 BOPD or is located in a Basic Order Pool.