

KANSAS CORPORATION COMMISSION OIL & GAS CONSERVATION DIVISION

1078128

Form CDP-1 May 2010 Form must be Typed

#### **APPLICATION FOR SURFACE PIT**

Submit in Duplicate

Operator Name: Val Energy, Inc.			License Number: 5822	
Operator Address: 200 W DOUGLAS AVE STE 520			WICHITA KS 67202	
Contact Person: TODD ALLAM			Phone Number: 316-263-6688	
Lease Name & Well No.: CIRCLE INDUSTRIES 4-32			Pit Location (QQQQ):	
Type of Pit:	Pit is:		NW NW SW SW	
Emergency Pit Burn Pit	X Proposed Existing		Sec. 32 Twp. 33 R. 10 East X West	
Settling Pit Drilling Pit	If Existing, date co	nstructed:	Feet from North / X South Line of Section	
Workover Pit X Haul-Off Pit  (If WP Supply API No. or Year Drilled)	Pit capacity:		Feet from East / X West Line of Section	
(in the stappy is the state of	3000	(bbls)	Barber County	
Is the pit located in a Sensitive Ground Water Area? Yes X No		Chloride concentration: mg/l  (For Emergency Pits and Settling Pits only)		
Is the bottom below ground level?	Artificial Liner?		How is the pit lined if a plastic liner is not used?	
Times Value	Yes No Yes X No		CLAY BOTTOM	
Pit dimensions (all but working pits):Length (feet)Width (feet)N/A: Steel Pits				
Depth from ground level to deepest point:3 (feet) No Pit				
1			dures for periodic maintenance and determining acluding any special monitoring.	
Distance to nearest water well within one-mile of pit: De		Depth to shallo	west fresh water feet.	
NA		Source of inform	<b></b>	
feet Depth of water wellfeet measured well owner				
Emergency, Settling and Burn Pits ONLY:		Drilling, Workover and Haul-Off Pits ONLY: FRESH MUD		
Producing Formation:		Type of material utilized in drilling/workover:		
Number of producing wells on lease:		Number of working pits to be utilized:		
Barrels of fluid produced daily:		Abandonment	COVER	
Does the slope from the tank battery allow all spilled fluids to flow into the pit? Yes No		Drill pits must b	e closed within 365 days of spud date.	
Submitted Electronically				
KCC OFFICE USE ONLY  Liner Steel Pit X RFAC X RFAS				
04/05/2012 15-007-23862-00-00 04/05/2012				
Date Received: Permit Number: Permit Date: Permit Date: Lease Inspection: X Yes No				

## Kansas Corporation Commission Oil & Gas Conservation Division

# HAUL-OFF PIT APPLICATION FILING REQUIREMENTS

82-3-607.	DISPOSAL OF DIKE AND PIT CONTENTS.			
(a)	Each operator shall perform one of the following when disposing of dike or pit contents:			
(1)	Remove the liquid contents to a disposal well or other oil and gas operation approved by the commission or to road maintenance or construction locations approved by the department;			
(2)	dispose of reserve pit waste down the annular space of a well completed according to the alternate requirements of K.A.R. 82-3-106, if the waste to be disposed of was generated during the drilling and completion of the well; or			
(3)	dispose of the remaining solid contents in any manner required by the commission. The requirements mainclude any of the following:			
	(A) Burial in place, in accordance with the grading and restoration requirements in K.A.R. 82-3-602 (f);			
	(B) removal and placement of the contents in an on-site disposal area approved by the commission;			
	(C) removal and placement of the contents in an off-site disposal area on acreage owned by the same landowner or to another producing lease or unit operated by the same operator, if prior written permission from the landowner has been obtained; or			
	(D) removal of the contents to a permitted off-site disposal area approved by the department.			
(b)	Each violation of this regulation shall be punishable by the following:			
	A \$1,000 penalty for the first violation; a \$2,500 penalty for the second violation; and a \$5,000 penalty and an operator license review for the third violation.			
Complete a	nd return with Haul-Off Pit Application, Form CDP1(2004)			
Haul-off pit v	vill be located in an on-site disposal area: ☑ Yes ☐ No			
□Yes □N	s located in an off-site disposal area on acreage owned by the same landowner: lo If yes, written permission from the land owner must be obtained. Attach written o haul-off pit application.			
	s located in an off-site disposal area on another <b>producing</b> lease or unit operated by the for: $\square$ Yes $\square$ No If yes, written permission from the land owner must be obtained. Attach			

permission and a copy of the lease assignment that covers the acreage where the haul-off pit is to be


located, to the haul-off pit application.

## **ADVANTAGE ELEVATIONS**

## BOX 8604 - PRATT, KS 67124 (620) 672-6491

OIL FIELD SURVEYORS

32123 INVOICE NO.

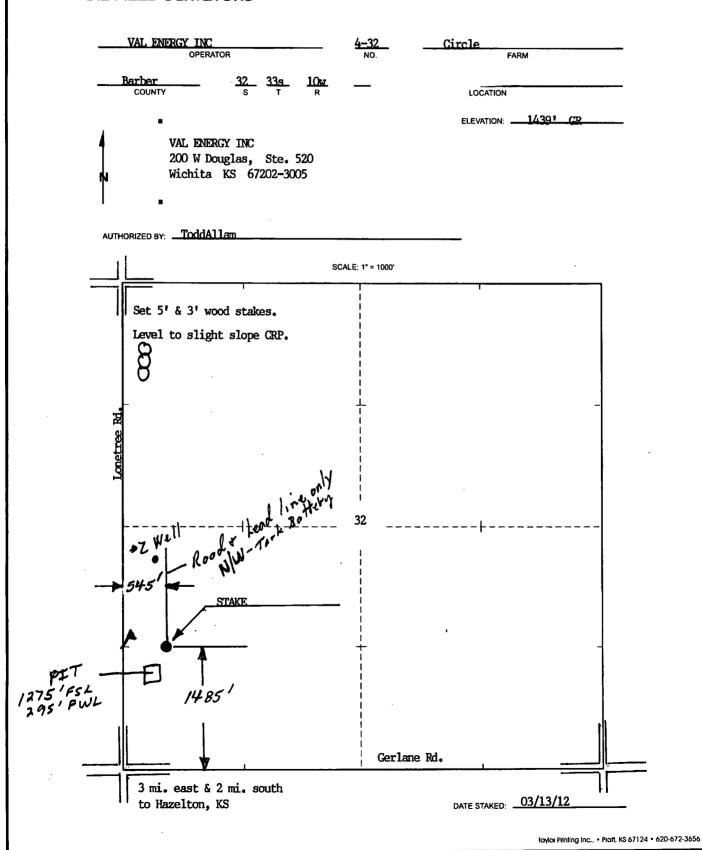

Conservation Division Finney State Office Building 130 S. Market, Rm. 2078 Wichita, KS 67202-3802



Phone: 316-337-6200 Fax: 316-337-6211 http://kcc.ks.gov/

Sam Brownback, Governor

Mark Sievers, Chairman Ward Loyd, Commissioner Thomas E. Wright, Commissioner

April 05, 2012

TODD ALLAM Val Energy, Inc. 200 W DOUGLAS AVE STE 520 WICHITA, KS 67202-3005

Re: Drilling Pit Application CIRCLE INDUSTRIES 4-32 Sec.32-33S-10W Barber County, Kansas

#### Dear TODD ALLAM:

District staff has inspected the above referenced location and has determined that the Haul-Off pit shall be constructed <u>without slots</u>, the bottom shall be flat and reasonably level and no deeper than 3'. The free fluids must be removed. The fluids are to be removed from the Haul-Off pit as soon as the Hutchinson Salt section has been drilled through and displacement of the fluids into the Haul-Off pit has occurred. The fluids should be removed again within 96 hours after drilling operations have ceased.

### NO completion fluids or non-exempt wastes shall be placed in the Haul-Off pit.

The fluids should be taken to an authorized disposal well. Please call the District Office at (620) 225-8888 when the fluids have been removed. Please file form CDP-5 (August 2008), Exploration and Production Waste Transfer, through KOLAR within 30 days of fluid removal.

If you have any questions or concerns please feel free to contact the District Office at (620) 225-8888.