

CARD MUST BE TYPED

State of Kansas
NOTICE OF INTENTION TO DRILL

CARD MUST BE SIGNED

(see rules on reverse side)

Starting Date: 8 27 84
month day year

API Number 15- 135-22,654-00-00

OPERATOR: License # 5123
Name Pickrell Drilling Company
Address 110 North Market, Suite 205
City/State/Zip Wichita, Kansas 67202
Contact Person Jay McNeil
Phone (316) 262-8427

C. NW SW Sec 32 Twp 17 S, Rge 21 East
(location) West

CONTRACTOR: License # 5123
Name Pickrell Drilling Company
City/State Wichita, Kansas 67202

..... 1980 Ft North from Southeast Corner of Section
..... 4620 Ft West from Southeast Corner of Section
(Note: Locate well on Section Plat on reverse side)

Well Drilled For: Well Class: Type Equipment:
 Oil Swd Infield Mud Rotary
 Gas Inj Pool Ext. Air Rotary
 OWWO Expl Wildcat Cable

Nearest lease or unit boundary line 660 feet.
County Ness
Lease Name Casey Well# 1-B
Domestic well within 330 feet : yes no
Municipal well within one mile : yes no

If OWWO: old well info as follows:

Operator
Well Name
Comp Date Old Total Depth
Projected Total Depth 4400 feet
Projected Formation at TD Miss
Expected Producing Formations Pennsylvanian - Miss

Depth to Bottom of fresh water 45 feet
Lowest usable water formation Dakota
Depth to Bottom of usable water 600 400 feet
Surface pipe by Alternate : 1 2
Surface pipe to be set 200+ feet
Conductor pipe if any required feet
Ground surface elevation 2183 feet MSL
This Authorization Expires 2-22-85
Approved By Jay McNeil

I certify that we will comply with K.S.A. 55-101, et seq., plus eventually plugging hole to K.C.C. specifications.

Date 8-21-84 Signature of Operator or Agent Jay McNeil

Title Geologist

MHC/KODAE 8/22/84
Form C-1 4/84

STATE

RECEIVED

Must be filed with the K.C.C. five (5) days prior to commencing well

This card void if drilling not started within six (6) months of date received by K.C.C.


AUG 22 1984

08-22-1984

CONSERVATION DIVISION

A Regular Section of Land

1 Mile = 5,280 Ft.

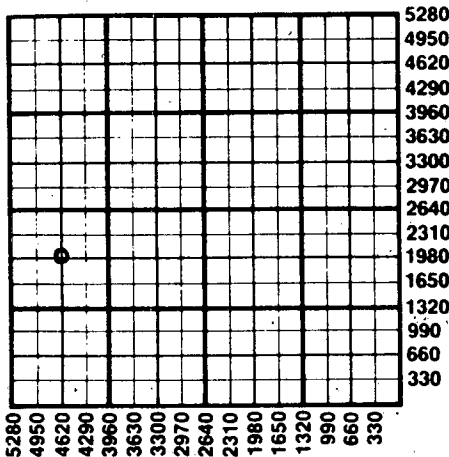

Important procedures to follow :

1. Notify District office before setting surface casing.
2. Set surface casing by circulating cement to the top.
3. File completion forms ACO-1 with K.C.C. within 90 days of well completion, following instructions on ACO-1, side 1, and including copies of wireline logs.
4. Notify District office 48 hours prior to old well workover or re-entry.
5. Prior to plugging, prepare a plugging plan, then obtain agreement from the appropriate district office for an approved plugging plan.
6. Submit plugging report (CP-4) to K.C.C. after plugging is completed.
7. Obtain an approved injection docket number before disposing of salt water.
8. Notify K.C.C. within 10 days when injection commences or terminates.
9. If an alternate 2 completion, cement in the production pipe from below any usable water to surface within 120 days of spud date.

State Corporation Commission of Kansas
Conservation Division
200 Colorado Derby Building
Wichita, Kansas 67202
(316) 263-3238