

CARD MUST BE TYPED

State of Kansas  
NOTICE OF INTENTION TO DRILL

CARD MUST BE SIGNED

(see rules on reverse side)

Starting Date: 5 15 85  
month day year

API Number 15- 135-22820-00-00

OPERATOR: License # 5123  
Name Pickrell Drilling Company  
Address 110 N. Market, Suite 205  
City/State/Zip Wichita, Kansas 67202  
Contact Person Jay McNeil  
Phone (316) 262-8427

NE SW SW Sec 17. Twp 17. S, Rge 25.  
(location)  East  West

990 Ft North from Southeast Corner of Section  
4290 Ft West from Southeast Corner of Section  
(Note: Locate well on Section Plat on reverse side)

CONTRACTOR: License # 5123  
Name Pickrell Drilling Company  
City/State Wichita, Kansas

Nearest lease or unit boundary line 990 feet.  
County Ness

Lease Name Elmore Well# 2-L

Domestic well within 330 feet:  yes  no  
Municipal well within one mile:  yes  no

Well Drilled For: Well Class: Type Equipment:  
 Oil  Swd  Infield  Mud Rotary  
 Gas  Inj  Pool Ext.  Air Rotary  
 OWWO  Expl  Wildcat  Cable

Depth to Bottom of fresh water 850 feet  
Lowest usable water formation Dakota  
Depth to Bottom of usable water 850 feet  
Surface pipe by Alternate: 1  2

If OWWO: old well info as follows:  
Operator  
Well Name  
Comp. Date Old Total Depth  
Projected Total Depth 4550 feet  
Projected Formation at TD Miss  
Expected Producing Formations Penn-Miss

Surface pipe to be set 250+ feet  
Conductor pipe if any required feet  
Ground surface elevation 2550 feet MSL  
This Authorization Expires 11-10-85  
Approved By 5-10-85

I certify that we will comply with K.S.A. 55-101, et seq., plus eventually plugging hole to K.C.C. specifications

Date 5-10-85 Signature of Operator or Agent

Jay C. McNeil  
Title Chief Geologist  
Dakota string will be cemented immediately if flow.

RECEIVED


STATE CORPORATION COMMISSION

Must be filed with the K.C.C. five (5) days prior to commencing well  
This card void if drilling not started within six (6) months of date received by K.C.C.

MAY 10 1985

CONSERVATION DIVISION  
Wichita, Kansas

A Regular Section of Land  
1 Mile = 5,280 Ft.

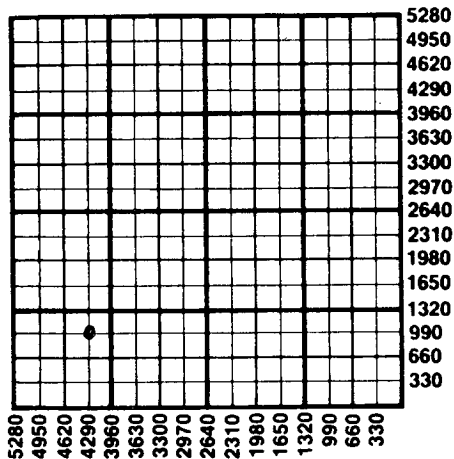

**Important procedures to follow:**

1. Notify District office before setting surface casing.
2. Set surface casing by circulating cement to the top.
3. File completion forms ACO-1 with K.C.C. within 90 days of well completion, following instructions on ACO-1, side 1, and including copies of wireline logs.
4. Notify District office 48 hours prior to old well workover or re-entry.
5. Prior to plugging, prepare a plugging plan, then obtain agreement from the appropriate district office for an approved plugging plan.
6. Submit plugging report (CP-4) to K.C.C. after plugging is completed.
7. Obtain an approved injection docket number before disposing of salt water.
8. Notify K.C.C. within 10 days when injection commences or terminates.
9. If an alternate 2 completion, cement in the production pipe from below any usable water to surface within 120 days of spud date.

State Corporation Commission of Kansas  
Conservation Division  
200 Colorado Derby Building  
Wichita, Kansas 67202  
(316) 263-3238