

CARD MUST BE TYPED

State of Kansas

CARD MUST BE SIGNED ✓
10

NOTICE OF INTENTION TO DRILL

(see rules on reverse side)

Expected Spud Date..... 7..... 25..... 87.....
month day year

API Number 15— 135-23,145-00-00

OPERATOR: License # 6759
Name WILLIAM N. BUCKLIN, III
Address 150 California St., Ste 300
San Francisco, CA 94111
City/State/Zip
Contact Person William N. Bucklin, III
Phone 415-433-7100

NW NW NW 29 17S 21W ~~4~~X
Sec..... Twp..... S, Rg..... West
4950
4950
Ft. from South Line of Section
Ft. from East Line of Section

(Note: Locate well on Section Plat on reverse side)

CONTRACTOR: License # 5302
Name Red Tiger Drilling Co.
Wichita, Kansas 67202
City/State.....

Nearest lease or unit boundary line 330 feet
County Ness
Lease Name Brenner Well # 2

Well Drilled For: Well Class: Type Equipment:
 Oil Storage Infield Mud Rotary
 Gas Inj Pool Ext. Air Rotary
 OWWO Expl Wildcat Cable

Ground surface elevation 2213 GR feet MSL
Domestic well within 330 feet: yes no
Municipal well within one mile: yes no

If OWWO: old well info as follows:

Depth to bottom of fresh water..... 200
Depth to bottom of usable water..... 550
Surface pipe by Alternate: 1 2

Operator
Well Name
Comp Date..... Old Total Depth.....

Surface pipe planned to be set 250
Conductor pipe required N/A
Projected Total Depth 4400 feet
Formation Miss

I certify that well will comply with K.S.A. 55-101, et seq., plus eventually plugging holes to KCC specifications
Date 7-21-87 Signature of Operator or Agent George A. Angler


For KCC Use:
Conductor Pipe Required feet; Minimum Surface Pipe Required 200 feet per Alt. ✓ ②
This Authorization Expires 1-22-88 Approved By Pat 7-22-87

Must be filed with the K.C.C. five (5) days prior to commencing well
 This card void if drilling not started within six (6) months of date received by K.C.C.

Important procedures to follow:

1. Notify District office before setting surface casing.
2. Set surface casing by circulating cement to the top.
3. File completion forms ACO-1 with K.C.C. within 120 days of well spud date, following instructions on ACO-1, side 1, and including copies of wireline logs.
4. Notify District office 48 hours prior to old well workover or re-entry.
5. Prior to filing Intent, prepare a proposed plugging plan in case well is D & A, then obtain approval of plan when calling district office prior to setting surface pipe.
6. Submit plugging report (CP-4) to K.C.C. after plugging is completed.
7. Obtain an approved injection docket number before disposing of salt water.
8. Notify K.C.C. within 10 days when injection commences or terminates.
9. If an alternate 2 completion, cement in the production pipe from below any usable water to surface within 120 days of spud date.

A Regular Section of Land
1 Mile = 5,280 Ft.

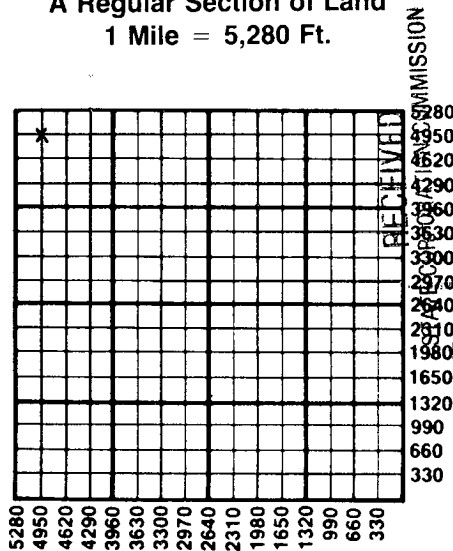

JUL 22 1987

07-22-1987

CONSERVATION DIVISION
 Wichita, Kansas

State Corporation Commission of Kansas
 Conservation Division
 200 Colorado Derby Building
 Wichita, Kansas 67202-1212
 (316) 263-3238