

15-135-00193-00-00


STATE OF KANSAS
STATE CORPORATION COMMISSION

Give All Information Completely
Make Required Affidavit
Mail or Deliver Report to:
Conservation Division
State Corporation Commission
800 Bitting Building
Wichita, Kansas

WELL PLUGGING RECORD

Ness County, Sec. 31 Twp. 17 Rge. 24 (E) (W)

NORTH

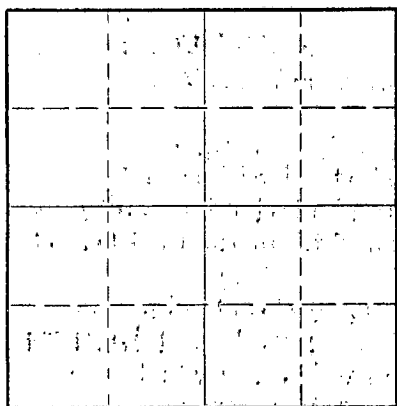

Locate well correctly on above
Section Plat

Location as "NE/CNW/SW" or footage from lines NE NE NW
Lease Owner Franco Central Oil Company
Lease Name Weeks Well No. 1
Office Address 512 Fourth National Bank Building
Character of Well (completed as Oil, Gas or Dry Hole) Dry Hole
Date well completed June 26, 1952 19 52
Application for plugging filed June 26, 1952 19 52
Application for plugging approved June 26, 1952 19 52
Plugging commenced June 26, 1952 19 52
Plugging completed June 26, 1952 19 52
Reason for abandonment of well or producing formation Dry Hole

If a producing well is abandoned, date of last production _____ 19 ____
Was permission obtained from the Conservation Division or its agents before plugging was commenced? Yes

Name of Conservation Agent who supervised plugging of this well Mr. Eldon Petty
Producing formation _____ Depth to top _____ Bottom _____ Total Depth of Well 4500 Feet
Show depth and thickness of all water, oil and gas formations.

OIL, GAS OR WATER RECORDS

CASING RECORD

FORMATION	CONTENT	FROM	TO	SIZE	PUT IN	PULLED OUT
				8 5/8"	305'	None

Describe in detail the manner in which the well was plugged, indicating where the mud fluid was placed and the method or methods used in introducing it into the hole. If cement or other plugs were used, state the character of same and depth placed, from _____ feet to _____ feet for each plug set.

Mudded hole to 300' and placed first wooden plug at 300' with 20 sacks cement and 1/2 half sack hulls. Mudded hole up to 35' and set second wooden plug at 35' and cemented with 15 sacks of cement to top of surface.


RECEIVED
STATE CORPORATION COMMISSION
07-09-1952

Name of Plugging Contractor Garvey Drilling Company
Address R. R. #2, Great Bend, Kansas

STATE OF KANSAS COUNTY OF SEDGWICK
W. W. Fisher Agent of Owner
well, being first duly sworn on oath, says: That I have knowledge of the facts, statements, and matters herein contained and the log of the above-described well as filed and that the same are true and correct. So help me God.

(Signature) W. W. Fisher
100 Derby Building, Wichita 2, Kansas
(Address)

SUBSCRIBED AND SWORN to before me this 2nd day of July, 19 52
October 13, 1954
My commission expires _____
Charlotte Sherman
Notary Public.

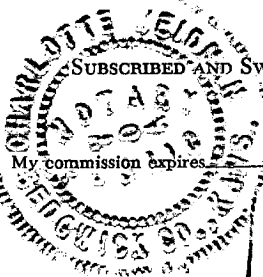

PLUGGING
FILE SEC 31 T 17 R 24c
BOOK PAGE 27 LINE 11

24-2675-S 2-52-20M

