


Give All Information Completely
Make Required Affidavit
Mail or Deliver Report to:
Conservation Division
State Corporation Commission
211 No. Broadway
Wichita, Kansas

WELL PLUGGING RECORD

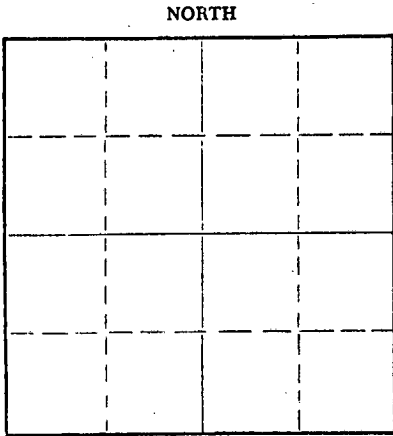

Locate well correctly on above
Section Plat

Ness County, Sec. 31 Twp. 17S Rge. 24W (E) (W)
Location as "NE/CNW/SW" or footage from lines C NE SE
Lease Owner Beardmore Drilling Company
Lease Name Rodie 'B' Well No. 1
Office Address 827 Beacon Building, Wichita, Kansas
Character of Well (completed as Oil, Gas or Dry Hole) Dry Hole
Date well completed 1-22-64 19
Application for plugging filed 1-22-64 19
Application for plugging approved 1-22-64 19
Plugging commenced 1-22-64 19
Plugging completed 1-22-64 19
Reason for abandonment of well or producing formation commercial quantities of oil not found
If a producing well is abandoned, date of last production 19
Was permission obtained from the Conservation Division or its agents before plugging was commenced? yes

Name of Conservation Agent who supervised plugging of this well Eldon Petty
Producing formation _____ Depth to top _____ Bottom _____ Total Depth of Well 4455 Feet
Show depth and thickness of all water, oil and gas formations.

OIL, GAS OR WATER RECORDS

CASING RECORD

FORMATION	CONTENT	FROM	TO	SIZE	PUT IN	PULLED OUT
				8 5/8	729'	

Describe in detail the manner in which the well was plugged, indicating where the mud fluid was placed and the method or methods used in introducing it into the hole. If cement or other plugs were used, state the character of same and depth placed, from _____ feet to _____ feet for each plug set.

Bottom Plug @ 600' w/ 20 sx.
2nd Plug @ 240' w/ 20 sx.
Top Plug @ 40' w/ 10 sx.

RECEIVED
STATE CORPORATION COMMISSION

JAN 30 1964
01-30-1964
CONSERVATION DIVISION
Wichita, Kansas

(If additional description is necessary, use BACK of this sheet)

Name of Plugging Contractor Walters Drilling Co.
Address 510 Orpheum Bldg., Wichita, Kansas

STATE OF KANSAS, COUNTY OF SEDGWICK, ss.
Robert F. Walters (employee of owner) or (owner or operator) of the above-described


well, being first duly sworn on oath, says: That I have knowledge of the facts, statements and matters herein contained and the log of the above-described well as filed and that the same are true and correct. So help me God.

(Signature) Robert F. Walters
510 Orpheum Building, Wichita, Kansas
(Address)

SUBSCRIBED AND SWORN TO before me this 27th day of January 1964

October 4, 1967

Juanita M. Green
Notary Public.

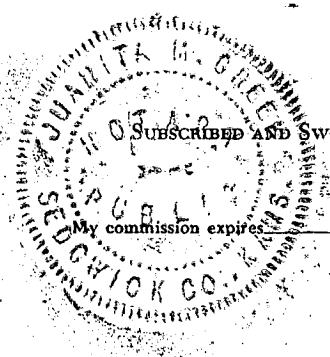

DRILLER'S LOG

COMPANY: BEARDMORE DRILLING COMPANY, ET AL
 827 BEACON BUILDING
 WICHITA, KANSAS

WELL NAME: RODIE 'B' #1
 C NE/4 SE/4 Sec. 31-17S-24W
 NESS COUNTY, KANSAS

CONTRACTOR: WALTERS DRILLING CO.
 510 ORPHEUM BUILDING
 WICHITA, KANSAS

ROTARY DRILLING COMMENCED: JANUARY 10, 1964

ROTARY DRILLING COMPLETED: JANUARY 22, 1964

ELEVATION: 2381 KB
 2378 DF
 2376 GL

CASING RECORD: 8 5/8" @ 729' W/ 375 sx. common cement

LOG

0 - 60	Rock
60 - 1040	Shale and Shells
1040 - 1052	Blaine Lime
1052 - 1150	Shale and Shells
1150 - 1400	Sand
1400 - 1664	Shale, Red Bed and Shells
1664 - 1700	Anhydrite
1700 - 1930	Shale, Red Bed and Shells
1930 - 2240	Shale
2240 - 2415	Shale and Lime
2415 - 2510	Anhydrite and Shale
2510 - 2625	Shale, Shells and Chalk Streaks
2625 - 2950	Lime and Shale
2950 - 3590	Shale and Lime
3590 - 3757	Lime
3757 - 3810	Lime and Shale
3810 - 3918	Lime
3918 - 3975	Lime and Shale
3975 - 4032	Lime
4032 - 4180	Lime and Shale
4180 - 4286	Lime
4286 - 4310	Lime and Shale
4310 - 4356	Lime
4356 - 4366	Cherty Lime
4366 - 4455	Lime and Chert
<u>4455</u>	<u>Rotary Total Depth - D & A</u>

RECEIVED
 STATE CORPORATION COMMISSION

JAN 30 1964
 01-30-1964
 CONSERVATION DIVISION
 Wichita, Kansas

The undersigned, Robert F. Walters, hereby certifies, in behalf of said company that the above log is a true and correct log of the formations encountered in drilling the above well as reflected by the Daily Drilling Reports.

WALTERS DRILLING CO.

Robert F. Walters
 ROBERT F. WALTERS, Partner

STATE OF KANSAS)
)
 COUNTY OF SEDGWICK) ss.

BE IT REMEMBERED that, on this 27th day of January, 1964, before me, the undersigned, a Notary Public duly commissioned in and for the State and County aforesaid, came Robert F. Walters, known to me to be the same person who executed the foregoing instrument as Partner and in behalf of the Walters Drilling Co. and he duly acknowledged the execution of the same for himself and for said company.

IN WITNESS WHEREOF, I have hereunto set my hand and official seal on the day and year last above written.

My Commission Expires:
 October 4, 1967

Juanita M. Green
 Juanita M. Green, Notary Public

