

STATE OF KANSAS
STATE CORPORATION COMMISSION

WELL PLUGGING RECORD

Give All Information Completely
Make Required Affidavit
Mail or Deliver Report to
Conservation Division
State Corporation Comm.
245 North Water
Wichita, KS 67202

Ness County. Sec. 29 Twp. 17S Rge. 24W E/W
Location as "NE/CNW $\frac{1}{4}$ SW $\frac{1}{4}$ " or footage from lines
C NE NE

Lease Owner John J. Darrah
Lease Name Gerstner Well No. #1


Office Address Suite 1010, Century Plaza Bldg., Wichita, Kansas
Character of Well (Completed as Oil, Gas or Dry Hole)
dry hole

Date Well completed March 6, 1977 19
Application for plugging filed March 6, 1977 19
Application for plugging approved March 6, 1977 19
Plugging commenced March 6, 1977 19
Plugging completed March 6, 1977 19
Reason for abandonment of well or producing formation
dry hole

If a producing well is abandoned, date of last production
19

Was permission obtained from the Conservation Division or
its agents before plugging was commenced? yes

Name of Conservation Agent who supervised plugging of this well Leo Massey, Hays, Kansas
Producing formation Depth to top Bottom Total Depth of Well
Show depth and thickness of all water, oil and gas formations.

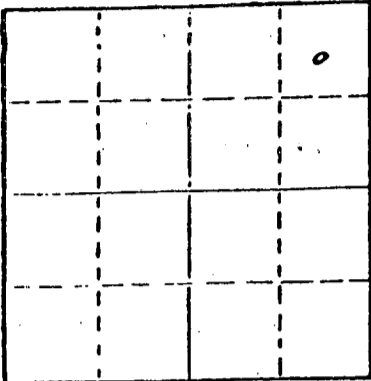

Locate well correctly on above
Section Plat

OIL, GAS OR WATER RECORDS

CASING RECORD

FORMATION	CONTENT	FROM	TO	SIZE	PUT IN	PULLED OUT
	8-5/8"	0	286			

Describe in detail the manner in which the well was plugged, indicating where the mud fluid was placed and the method or methods used in introducing it into the hold. If cement or other plugs were used, state the character of same and depth placed, from feet to feet for each plug set. Plugged 720' with 70 sacks 50-50 pozmix, 6% gel; plugged at 240' with 20 sacks 50-50 pozmix, 6% gel; plugged at 40' with 10 sacks 50-50 pozmix, 6% gel. Plug down at 2:00 p.m., March 6, 1977.

RECEIVED
STATE CORPORATION COMMISSION

MAR 14 1977
03 14 1977
CONSERVATION DIVISION
Wichita, Kansas

(If additional description is necessary, use BACK of this sheet)

Name of Plugging Contractor Strata Drilling Company


STATE OF KANSAS COUNTY OF BARTON, ss.
Kenneth J. Link (employee of owner) or (owner or operator)
of the above-described well, being first duly sworn on oath, says: That I have knowledge of the facts, statements, and matters herein contained and the log of the above-described well as filed and that the same are true and correct. So help me God.

(Signature) Kenneth J. Link President
Box 355, Great Bend, Kansas 67530
(Address)

SUBSCRIBED AND SWORN TO before me this 9th day of March, 1977.

Loneita Barry
Loneita Barry Notary Public.

My commission expires 3-28-80

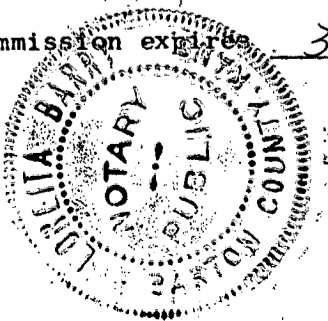

RECEIVED
MAR 11 1977
John Jay Darrah Jr.

DRILLERS LOG

15-135-21298-10-00

#1 Gerstner

CASING RECORD:
281' new 20#
8-5/8" surface
casing

COMPANY: John J. Darrah
CONTRACTOR: Strata Drilling Company
COMMENCED: February 27, 1977
COMPLETED: March 6, 1977

DESCRIPTION: E NE NE
Section 29-17S-24W
Ness County, Kansas
ELEVATION: 2243 KB

TOTAL DEPTH:
4389'

D & A

<u>FORMATION</u>	<u>FROM</u>	<u>TO</u>	<u>REMARKS</u>
Surface soil, shale	0	300	Ran 281' new 20# 8-5/8" casing, set and cemented at 286' with 185 sacks common cement, 2% gel, 3% c.c.; cement circulated. Plug down @ 11:45 p.m., February 27, 1977.
Shale	300	1679	
Anhydrite	1679	1711	
Shale, red bed	1711	2195	
Lime and shale	2195	4389	

TOTAL ROTARY DEPTH: 4389'

Ran one electric log.

Ran one drill stem test.

RECEIVED
STATE CORPORATION COMMISSION

MAY 09 1977
05-09-1977
CONSERVATION DIVISION
Wichita, Kansas

Hole plugged as follows: plugged at 720' with 70 sacks 50-50 pozmix, 6% gel; plugged at 240' with 20 sacks 50-50 pozmix, 6% gel; plugged at 40' with 10 sacks 50-50 pozmix, 6% gel. Plug down at 2:00 p.m., March 6, 1977.

STATE OF KANSAS)
) ss
COUNTY OF BARTON)

I certify that this is a true and correct copy of the above log to the best of my knowledge.

STRATA DRILLING COMPANY

Kenneth J. Link
Kenneth J. Link, President

Subscribed and sworn to before me this 9th day of March, 1977.

My Commission expires: 3-28-80

Loneita Barry
Loneita Barry, Notary Public

