

state

15-051-03533-0000


STATE OF KANSAS  
STATE CORPORATION COMMISSION

WELL PLUGGING RECORD

Give All Information Completely  
Make Required Affidavit  
Mail or Deliver Report to:  
Conservation Division  
State Corporation Commission  
800 Bitting Building  
Wichita, Kansas

Ellis County, Sec. 31 Twp. 11S Rge. (E) 18 (W)

Location as "NE/CNW $\frac{1}{4}$ /SW $\frac{1}{4}$ " or footage from lines SE NW NE  
Lease Owner Shell Oil Company  
Lease Name W. JOHNSON, JR. Well No. 4  
Office Address Box 744, Great Bend, Kansas  
Character of Well (completed as Oil, Gas or Dry Hole) Dry Hole  
Date well completed April 12 1948  
Application for plugging filed June 19 1950  
Application for plugging approved June 20 1950  
Plugging commenced July 13 1950  
Plugging completed July 15 1950  
Reason for abandonment of well or producing formation Dry Hole

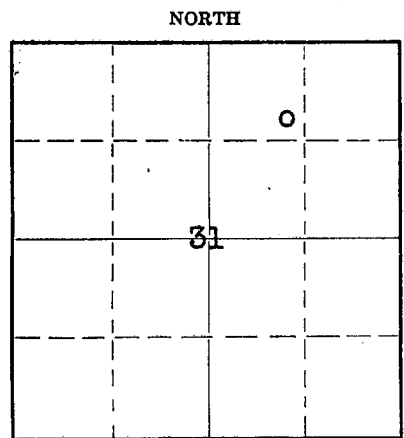

Locate well correctly on above  
Section Plat

If a producing well is abandoned, date of last production - 19...  
Was permission obtained from the Conservation Division or its agents before plugging was commenced? Yes

Name of Conservation Agent who supervised plugging of this well Eldon Petty  
Producing formation 3628 Depth to top 3628 Bottom Total Depth of Well 3679 Feet  
Show depth and thickness of all water, oil and gas formations. 3601 PB

OIL, GAS OR WATER RECORDS

CASING RECORD

Formation	Content	From	To	Size	Put In	Pulled Out
Arbuckle	570' water 7 $\frac{1}{2}$ hrs.	3629	3679	8 5/8" 4 $\frac{1}{2}$ "	1414' 3629'	None 2356'

Describe in detail the manner in which the well was plugged, indicating where the mud fluid was placed and the method or methods used in introducing it into the hole. If cement or other plugs were used, state the character of same and depth placed, from... feet to... feet for each plug set.

Filled hole with rock from 3601 to 3350'  
& dumped 4 sax cement. Mudded hole to  
260', set 10' rock bridge & dumped 15 sax  
cement. Mudded to 35' & capped with 10  
sax cement.

(If additional description is necessary, use BACK of this sheet)

Correspondence regarding this well should be addressed to Shell Oil Company  
Address c/o S. S. Mabry, Box 744, Great Bend, Kansas

STATE OF KANSAS, COUNTY OF BARTON, ss.  
S. S. Mabry (employee of owner) of the above-described well,  
being first duly sworn on oath, says: That I have knowledge of the facts, statements, and matters herein contained and the log of the above-described well as filed and that the same are true and correct. So help me God.

(Signature) *S. S. Mabry*  
Box 744, Great Bend, Kansas  
(Address)

SUBSCRIBED AND SWORN to before me this 6th day of September, 1950  
January 24, 1953  
My commission expires

*Betty Postlethwaite*  
Notary Public.



22-5133-s 9-48-10M

PLUGGING  
FILE SEC 31 T 11 R 18  
BOOK PAGE 18 LINE 6

SHELL, W. JOHNSON, JR. #4  
SE NW NE 31-11S-18W  
Riverview Pool  
Ellis County, Kansas

0 - 40 rock & clay  
75 clay & sand  
252 clay  
395 clay & sand  
525 shale  
620 shale & shells  
675 sand  
730 shale & shells  
800 shale  
825 shale & shells  
925 shale & lime  
970 shale & shells  
1025 pyrite  
1060 sand & gravel  
1135 red bed & shale  
1250 red bed & lime shells  
1404 red bed  
1445 anhydrite  
1575 red bed  
1590 shale  
1775 shale & shells  
1825 salt  
2185 shale & shells  
2340 sandy lime & shale  
2415 lime & shale  
2450 lime  
2465 sandy lime  
2705 lime & shale  
2765 lime, broken  
3165 lime & shale  
Top Topoka 3080  
3195 lime  
3306 lime & shale  
Top Lans-Kans City 3305  
3425 lime  
3455 lime & shale  
3580 lime Top Sooy 3580  
3620 conglomerate  
Top Simpson 3620  
3628 shale  
Top Arbuckle 3628  
3679 dolomite TD  
3601 PB

Casing Record

8 5/8" cem 1414 with 800 sax; cemented  
to top with 18 sax.

4 1/2" cem 3629 with 200 sax; centralizers  
at 3628, 3565, 3410 & 3378. Perforated  
3395-3400; 3379-83; & 3388-92.

