


Give All Information Completely
Make Required Affidavit
Mail or Deliver Report to:
Conservation Division
State Corporation Commission
800 Biting Building
Wichita, Kansas

WELL PLUGGING RECORD

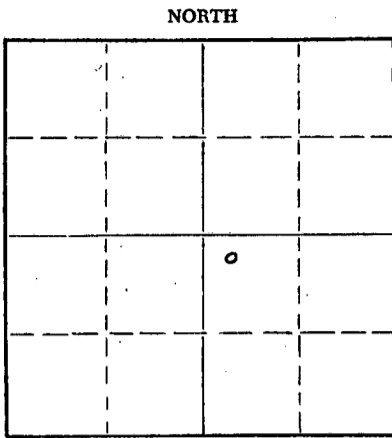

Locate well correctly on above Section Plat

Ellis County. Sec. 31 Twp. 11S Rge. 18 OEX (W)
Location as "NE/CNW/SW" or footage from lines NW NW SE
Lease Owner El Dorado Refining Company
Lease Name Pfeifer Well No. 1
Office Address 306 Koch Building, Wichita, Kansas
Character of Well (completed as Oil, Gas or Dry Hole) dry hole
Date well completed 11-17-55 19
Application for plugging filed 11-17-55 19
Application for plugging approved 11-17-55 19
Plugging commenced 11-17-55 19
Plugging completed 11-17-55 19
Reason for abandonment of well or producing formation _____

If a producing well is abandoned, date of last production _____ 19
Was permission obtained from the Conservation Division or its agents before plugging was commenced? yes, verbally

Name of Conservation Agent who supervised plugging of this well Eldon Petty
Producing formation _____ Depth to top _____ Bottom _____ Total Depth of Well 3785 Feet
Show depth and thickness of all water, oil and gas formations.

OIL, GAS OR WATER RECORDS

CASING RECORD

FORMATION	CONTENT	FROM	TO	SIZE	PUT IN	PULLED OUT
Surface soil, sand & shale		0	269	8 5/8	269	none
Heebner		3373				
Toronto		3396				
Lansing		3418				
Shaley Conglomerate		3671				
Cherty Conglomerate		3681				
Reworked Simpson		3701	3785			

Describe in detail the manner in which the well was plugged, indicating where the mud fluid was placed and the method or methods used in introducing it into the hole. If cement or other plugs were used, state the character of same and depth placed, from _____ feet to _____ feet for each plug set.

Filled hole with heavy mud to 250', set bottom plug at 250' with 15 sax cement, filled with heavy mud, set top plug at 40' with 10 sax cement, and leveled location.

RECEIVED
STATE CORPORATION COMMISSION
NOV 26 1955
CONSERVATION DIVISION
Wichita, Kansas

(If additional description is necessary, use BACK of this sheet)
Name of Plugging Contractor Ben F. Brack Oil Company, Inc. (Drilling Contractor)
Address 309 Brown Building, Wichita 2, Kansas

STATE OF Kansas, COUNTY OF Sedgwick, ss.
Frank M. Brooks (employee of owner) or (owner/operator) of the above-described well, being first duly sworn on oath, says: That I have knowledge of the facts, statements, and matters herein contained and the log of the above-described well as filed and that the same are true and correct. So help me God.

(Signature) Frank M. Brooks
(Frank M. Brooks)
306 Koch Building, Wichita 2, Kansas
(Address)

SUBSCRIBED AND SWORN TO before me this 25th day of November, 1955

My commission expires May 24, 1958

Margaret S. Freund
(Margaret S. Freund) Notary Public.

PLUGGING
WELL SEC 31 T 11 R 18 W
BOOK PAGE 18 LINE 33

BEN F. BRACK OIL COMPANY, INC.
309-10 BROWN BUILDING
WICHITA 2, KANSAS

PFEIFER #1

NW NW SE

Sec. 31-118-18 J
Ellis County, Kansas
Commenced: 11-7-55
Completed: 11-17-55

TOTAL DEPTH: 3785'
ELEVATION: 2123' DF

WELL LOG

Surface Soil & Sand	0 -	90'
Shale		269
Blue Shale		580
Red Bed & Shale		920
Sand & Shale		970
Sand		1150
Shale		1470
Anhydrite		1510
Shale & Shells		1995
Lime & Shale		2055
Lime		2225
Shale & Lime		2335
Lime & Shale		2420
Lime		2490
Lime & Shale		2559
Shale & Lime		2685
Shale & Shells		3226
Lime & Shale		3287
Lime		3328
Lime & Shale		3383
Lime		3655
Lime & Shale		3705
Lime		3785' T.D. D & A

The above depths denote bottom of formations.

CASING

8 5/8" 269'

To the best of my knowledge, the above is a true and correct statement of the depths and formations and where found.

BEN F. BRACK OIL COMPANY, INC.

By Bernard A. Grant

WITNESSED:

Arthur Crist

November 21, 1955.

PLUGGING
FILE SEC 31 T 11 R 18 W
BOOK PAGE 18 LINE 32

RECORDED
COMMISSION
NOV 25 1955
REGISTRATION DIVISION
Wichita, Kansas