


STATE OF KANSAS
STATE CORPORATION COMMISSION

WELL PLUGGING RECORD

Give All Information Completely
Make Required Affidavit
Mail or Deliver Report to
Conservation Division
State Corporation Comm.
245 North Water
Wichita, KS 67202

Ness County. Sec. 5 Twp. 17S Rge. 24 E/W
Location as "NE/CNW $\frac{1}{4}$ /SW $\frac{1}{4}$ " or footage from lines
C NW SW

Lease Owner Petroleum, Inc.
Lease Name Somy Well No. 1
Office Address Box 1447, Great Bend, Kansas 67530
Character of Well (Completed as Oil, Gas or Dry Hole)
oil

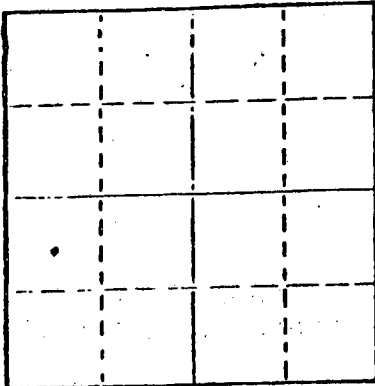

Locate well correctly on above
Section Plat

Date Well completed 19
Application for plugging filed 19
Application for plugging approved 19
Plugging commenced June 17 1977
Plugging completed July 8 1977
Reason for abandonment of well or producing formation
depleted

If a producing well is abandoned, date of last production 19

Was permission obtained from the Conservation Division or
its agents before plugging was commenced? yes

Name of Conservation Agent who supervised plugging of this well Leo F. Massey
Producing formation Depth to top Bottom Total Depth of Well 4532'
Show depth and thickness of all water, oil and gas formations.

OIL, GAS OR WATER RECORDS

CASING RECORD

FORMATION	CONTENT	FROM	TO	SIZE	PUT IN	PULLED OUT
			287'	8 5/8"	287'	none
			4531'	5 1/2"	4531'	3801.31

Describe in detail the manner in which the well was plugged, indicating where the mud fluid
was placed and the method or methods used in introducing it into the hold. If cement or other
plugs were used, state the character of same and depth placed, from _____ feet to
_____ feet for each plug set.

Sanded back to 4390' and dumped 4 sacks of cement.

Sun Oil Well Cementing, Inc. plugged well pumping in 2 sacks of hulls,
32 sacks of gel and 150 sacks of cement.

RECEIVED
STATE CORPORATION COMMISSION
JUL 11 1977

07-11-1977

(If additional description is necessary, use BACK of this sheet)
Name of Plugging Contractor PIPE PULLERS, INC.
Box 128, Ellinwood, Kansas 67526

STATE OF KANSAS COUNTY OF BARTON ss.
Evelyn Roth

(employee of owner) or (owner or operator) of the above-described
well, being first duly sworn on oath, says: That I have knowledge of the facts, statements, and matters herein contained and the log of the
above-described well as filed and that the same are true and correct. So help me God.

(Signature) Evelyn Roth
Ellinwood, Kansas

(Address)

SUBSCRIBED AND SWORN TO before me this 8th day of July 19 77

My commission expires

JENNY KASSELMAN
NOTARY PUBLIC
BARTON COUNTY, KANSAS
MY COMM. EXP. JULY 16, 1978

Notary Public.

15-135-21087-0000

DRILLERS' LOG

PETROLEUM, INC.
No. 1 Somy
C NW SW, Sec. 5-17S-24W
Ness County, Kansas

Elev: 2517 K.B.

Commenced: 9-3-75
Completed: 9-13-75

Surface: 279' of 8-5/8"
cemented w/185 sx common
cement, 2% Gel, 3% cc.
9-3-75

<u>FORMATION</u>	<u>DEPTH</u>
Surface Hole	0 - 287
Shale	287 - 1237
Blaine Anhydrite	1237 - 1247
Sand & Shale 12	1247 - 1660
Red Bed & Shale	1660 - 1863
Anhydrite	1863 - 1890
Shale	1890 - 2150
Shale & Lime	2150 - 2705
Lime & Shale	2705 - 2945
Shale & Lime	2945 - 3205
Lime & Shale	3205 - 3790
Lime	3790 - 4522
Chert	4522 - 4532 RTD

RECEIVED
STATE CORPORATION COMMISSION
JUL 12 1977
07-12-1977
CONSERVATION DIVISION
Wichita, Kansas

I do hereby certify that the foregoing statements are true and correct to the best of my knowledge and belief.

D N B DRILLING, INC.

James L. Donelson
JAMES L. DONELSON

STATE OF KANSAS: ss:

Subscribed and sworn to before me this 17th day of September, 1975.

Ella Priess

Ella Priess, Notary Public

Ella Priess
STATE NOTARY PUBLIC
Sedgwick County, Kansas
My Com. Expires Aug. 25, 1976