


STATE OF KANSAS
STATE CORPORATION COMMISSION

WELL PLUGGING RECORD

Give All Information Completely
Make Required Affidavit
Mail or Deliver Report to
Conservation Division
State Corporation Comm.
245 North Water
Wichita, KS 67202

Ness County, Sec. 5 Twp. 17S Rge. 24W E/W
Location as "NE/CNW $\frac{1}{4}$ SW $\frac{1}{4}$ " or footage from lines
NW SW SW

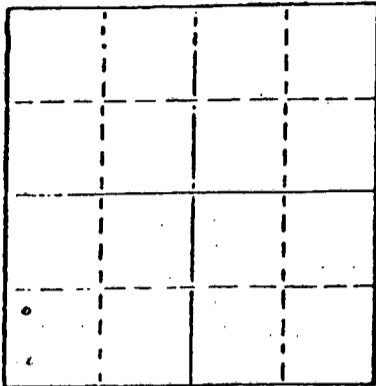

Locate well correctly on above
Section Plat

Lease Owner Petroventures, Inc.
Lease Name Somy Well No. 1
Office Address 4704 Harlan Street, Suite 600 Denver, CO 80212
Character of Well (Completed as Oil, Gas or Dry Hole)

DRY HOLE
Date Well completed April 8, 1981
Application for plugging filed April 8, 1981
Application for plugging approved April 8, 1981
Plugging commenced April 8, 1981
Plugging completed April 8, 1981

Reason for abandonment of well or producing formation
DRY HOLE
If a producing well is abandoned, date of last production 19

Was permission obtained from the Conservation Division or its agents before plugging was commenced? YES

Name of Conservation Agent who supervised plugging of this well Marion Schmidt
Producing formation _____ Depth to top _____ Bottom _____ Total Depth of Well 4,525'
Show depth and thickness of all water, oil and gas formations.

OIL, GAS OR WATER RECORDS

CASING RECORD

FORMATION	CONTENT	FROM	TO	SIZE	PUT IN	PULLED OUT
				8-5/8"	309'	

Describe in detail the manner in which the well was plugged, indicating where the mud fluid was placed and the method or methods used in introducing it into the hold. If cement or other plugs were used, state the character of same and depth placed, from _____ feet to _____ feet for each plug set.

Mud to 1,170' 65 sx cement
Mud to 330', 30 sx cement
Mud to 40', plug, 1/2 sx hulls,
10 sx cement, 5 sx in rathole

(If additional description is necessary, use BACK of this sheet)

Name of Plugging Contractor _____

STATE OF Kansas COUNTY OF Sedgwick, ss.
Donale E. Hunt (employee of owner) or (owner or operator)

of the above-described well, being first duly sworn on oath, says: That I have knowledge of the facts, statements, and matters herein contained and the log of the above-described well as filed and that the same are true and correct. So help me God.

(Signature) Donale E. Hunt
Suite 250, 200 West Douglas, Wichita, Kansas
(Address)

SUBSCRIBED AND SWORN TO before me this 10th day of April, 1981

My commission expires January 20, 1985



Kathleen L. Grege
STATE CORPORATION COMMISSION Notary Public.

MAY - 4 1981
05-04-1981
CONSERVATION DIVISION
Wichita, Kansas

