


15-135-20577-0000

FORM CP-4

STATE OF KANSAS
STATE CORPORATION COMMISSION
CONSERVATION DIVISION
P. O. BOX 17027
WICHITA, KANSAS 67217

WELL PLUGGING RECORD

Ness County, Sec. 2 Twp. 17 Rge. 24 (E) (W) X
Location as "NE/CNWSW2" or footage from lines W/2 SW SE
Lease Owner Okmar Oil Co.
Lease Name Klitzke Well No. #1
Office Address 1130 Vickers KSB&T Bldg. Wichita, Kansas 67202
Character of Well (completed as Oil, Gas or Dry Hole)
Date well completed 19
Application for plugging filed 19
Application for plugging approved 19
Plugging commenced 9-7-74 19
Plugging completed 10-1-74 19
Reason for abandonment of well or producing formation
If a producing well is abandoned, date of last production 19
Was permission obtained from the Conservation Division or its agents before plugging was commenced?

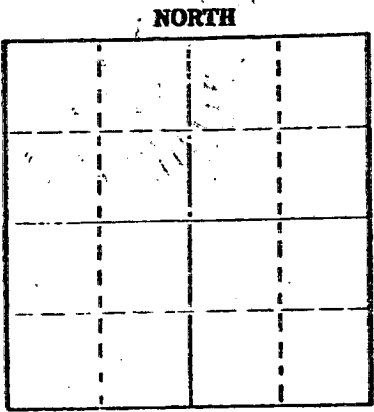

Locate well correctly on above Section Plot

Name of Conservation Agent who supervised plugging of this well Leo Massey
Producing formation Depth to top Bottom Total Depth of Well 4480' Feet
Show depth and thickness of all water, oil and gas formations.

OIL, GAS OR WATER RECORDS CASING RECORD

FORMATION	FROM	TO	SIZE	PUT IN	PULLED OUT
			5 1/2"	4468'	2377.49'
			8 5/8"	283.42'	

RECEIVED FROM STATE CORPORATION COMMISSION OCT 10 1974 CONSERVATION DIVISION Wichita, Kansas


Describe in detail the manner in which the well was plugged, indicating where the mud fluid was placed and the method or methods used in introducing it into the hole. If cement or other plugs were used, state the character of same and depth placed, from feet to feet for each plug set.

Made bottom hole plug back with sand to 4450'. Mixed and ran 4 sacks cement thru dump bailer.
Pump 20 sacks gel - 2 sacks hulls - 70 sacks cement, 10 sacks gel. Plug with 50 sacks cement.

(If additional description is necessary, use BACK of this sheet)
Name of Plugging Contractor Southwest Casing Pulling Co.
Address Box 364 Great Bend, Kansas

STATE OF Kansas COUNTY OF Barton ss.
Southwest Casing Pulling Co. (employee of owner) or (owner or operator) of the above-described well, being first duly sworn on oath, says: That I have knowledge of the facts, statements, and matters herein contained and the log of the above-described well as filed and that the same are true and correct. So help me God.

(Signature) W. C. Spencer Sec.
Box 364 Great Bend, Kansas (Address)

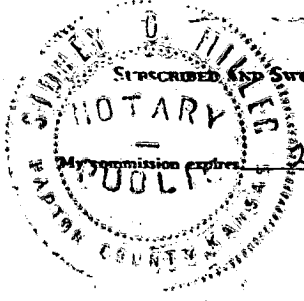

Subscribed and sworn to before me this 9 day of October 1974
Sidney D. Willhite Notary Public.

15135-20577-0000

DRILLERS LOG

#1 Klitzke

CASING RECORD:
277.42' of used 8-5/8"
surface casing.

COMPANY: Okmar Oil Company
CONTRACTOR: Strata Drilling, Inc.

DESCRIPTION: W/2 SW SE
Section 2-17S-24W
Ness County, Kansas

TOTAL DEPTH:
4480'

COMMENCED: February 16, 1972
COMPLETED: February 26, 1972

ELEVATION: 2509' D.F.
2512' K.B.

<u>FORMATION</u>	<u>FROM</u>	<u>TO</u>	<u>REMARKS</u>
Clay, Post Rock, Shale, Sand & Shells	0	304	Ran 277.42' of used 8-5/8" surface casing; set and cemented at 283.42' with 160 sacks of common cement, 2% gel and 3% C. C. Plug down at 9:40 P. M. February 16, 1972.
Shale	304	494	
Shale, Clay w/Sand Streaks	494	1130	
Red Bed & Shale	1130	1254	
Dakota Sand	1254	1538	
Red Bed & Shale	1538	1809	
#2 Anydrite	1809	1841	
Shale	1841	1933	
Shale & Clay	1933	2305	
Shale, Shells w/Broken Lime	2305	2536	
Lime & Shale	2536	3710	
Shale, Lime w/Sand Streaks	3710	3866	
Lime & Shale	3866	4156	
Lime	4156	4468	
Lime & Chert	4468	4480	

ROTARY TOTAL DEPTH: 4480'

RECEIVED
STATE CORPORATION COMMISSION
AUG 29 1974
CONSERVATION DIVISION
Wichita, Kansas
08-29-1974

5 1/2" casing set and cemented at 4468' with 75 sacks of 60-40 pozmix, salt saturated. Plug down at 1:45 P. M. February 26, 1972.

STATE OF KANSAS)
) ss.
COUNTY OF BARTON)

I certify that this is a true and correct copy of the above log to the best of my knowledge.

STRATA DRILLING, INC.

Charles W. Steincamp
Charles W. Steincamp, President

Subscribed and sworn to before me this 28th day of February, 1972.

My Commission Expires:
December 14, 1973

Elaine H. Taylor
Elaine H. Taylor, Notary Public

