


STATE OF KANSAS  
STATE CORPORATION COMMISSION

Give All Information Completely  
Make Required Affidavit  
Mail or Deliver Report to:  
Conservation Division  
State Corporation Commission  
800 Bittling Building  
Wichita, Kansas

WELL PLUGGING RECORD

Ness County, Sec. 2 Twp. 17 Rge. 24 (E) (W)

Location as "NE/CNW/SW" or footage from lines SW SW NE  
Lease Owner Welch & Olsson Drilling Company, Inc.  
Lease Name Horchem Well No. 1  
Office Address 203 Rule Bldg. Wichita, Kansas  
Character of Well (completed as Oil, Gas or Dry Hole) D & A  
Date well completed 11-12 19 55  
Application for plugging filed 11-12 19 55  
Application for plugging approved 11-12 19 55  
Plugging commenced 11-12 19 55  
Plugging completed 11-12 19 55  
Reason for abandonment of well or producing formation D & A

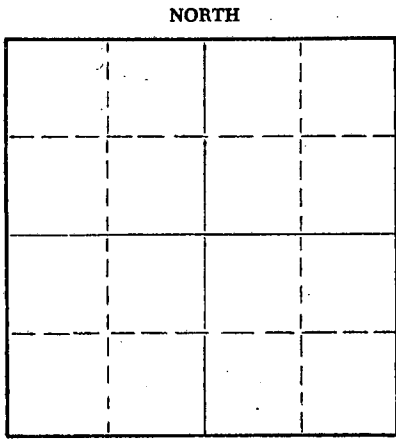

Locate well correctly on above  
Section Plat

If a producing well is abandoned, date of last production None 19  
Was permission obtained from the Conservation Division or its agents before plugging was commenced? Yes

Name of Conservation Agent who supervised plugging of this well Warren H. Horner, Box 207, Great Bend, Ks.  
Producing formation \_\_\_\_\_ Depth to top \_\_\_\_\_ Bottom \_\_\_\_\_ Total Depth of Well 4595' Feet  
Show depth and thickness of all water, oil and gas formations.

OIL, GAS OR WATER RECORDS

CASING RECORD

FORMATION	CONTENT	FROM	TO	SIZE	PUT IN	PULLED OUT
				8 5/8	137'	None

Describe in detail the manner in which the well was plugged, indicating where the mud fluid was placed and the method or methods used in introducing it into the hole. If cement or other plugs were used, state the character of same and depth placed, from \_\_\_\_\_ feet to \_\_\_\_\_ feet for each plug set.


Mudded to 200'. Added 1/4th sack of hulls. Cemented with 25 sacks of cement thru drill pipe. Plug set at 35'. Added 1/4th sack of hulls and cemented with 15 sacks of cement.

(If additional description is necessary, use BACK of this sheet)  
Name of Plugging Contractor Welch & Olsson Drilling Company, Inc.  
Address 203 Rule Bldg. Wichita, Kansas.

STATE OF Kansas, COUNTY OF Sedgwick, ss.  
R. E. Welch (employee or owner) or (owner or operator) of the above-described well, being first duly sworn on oath, says: That I have knowledge of the facts, statements, and matters herein contained and the log of the above-described well as filed and that the same are true and correct. So help me God.

(Signature) [Signature] 203 Rule Bldg. Wichita, Kansas. (Address)

SUBSCRIBED AND SWORN to before me this 17th day of November, 19 55  
June 12, 1959  
My commission expires \_\_\_\_\_  
Edith Erker, Notary Public.

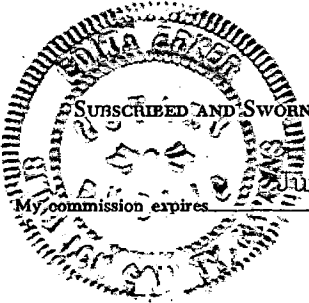

PLUGGING  
FILE SEC 2 T 17 R 24W  
BOOK PAGE 18 LINE 39

RECEIVED  
STATE CORPORATION COMMISSION  
NOV 25 1955  
11-25-1955  
CONSERVATION DIVISION  
Wichita, Kansas

15-135-0 0013-00-00

WELL LOG.

WELCH & OLSSON DRILLING COMPANY, INC.

Elevation: 2516 R.B.

CONTRACTOR: Welch & Olsson Drilling Co. Inc.

Commenced Drlg: 10-31-55

HORCHEM #1  
SW SW NE Sec. 2-17-24W  
Ness County, Kansas.

Compl Drlg: 11-12-55

Production: D & A

Casing Record.

Set 137' of 8 5/8" with 125 sacks of cement.


(Figures indicate bottom of formations.)

<u>FORMATIONS?</u>	<u>DEPTHS</u>	<u>FORMATION TOPS.</u>	
Clay & Shale:	135	Heebner:	3851 (-1335)
Shale:	650	Toronto:	3869 (-1353)
Shale & Red Bed:	760	Lansing-Kansas City:	3892 (-1376)
Sand:	1165	Base Kansas City:	4190 (-1674)
Anhydrite:	1185	Fort Scott:	4394 (-1878)
Red Bed & Shale:	1275	Cherokee Section:	4458 (-1942)
Sand:	1560	Mississippian:	4493 (-1977)
Shale & Shells:	2450		
Shale & Lime:	2520		
Lime & Shale:	2765		
Shale & Lime:	2930		
Lime & Shale:	2990		
Shale & Shells:	3260		
Shale:	3435		
Shale W/Lime Stra.	3495		
Shale & Lime:	2765		
Lime & Shale:	3915		
Lime:	4340		
Lime & Shale:	4500		
Sand:	4595 T.D.		

STATE OF KANSAS, )  
                                  )SS:  
SEDGWICK COUNTY, )

I hereby certify that the above is a true and correct copy of Drillers Log of well drilled in the SW SW NE of Sec. 2, Twp. 17, Rge 24 W, Ness County, Kansas.

WELCH & OLSSON DRILLING COMPANY, INC.

BC   
R. E. WELCH

Subscribed and sworn to before me this 17th day of November, 1955

  
Edith Erker, Notary Public.

My commission expires:  
June 12, 1959

RECEIVED  
STATE CORPORATION COMMISSION

NOV 25 1955

CONSERVATION DIVISION  
Wichita, Kansas

11-25-1955

PLUGGING  
FILE SEC 2 T 17 R 34 W  
BOOK PAGE 18 LINE 39